

The Big

SHOP DRAWING (SDW)

Project	The Big Business District	S.D/Submittal No.	Rev.
Owner	ROYA Developments	BD-CW-SAMCO-PCO-SDW-STR-054	02
Project Manager	ACE-PM	Date: 01-06-2026 (3 Working days)	
Supervision Consultant	PRIME CONSULTING OFFICE	Submitted For	
Contractor	SAMCO National Construction	Approval	
		Information	

SD Subject	RFT DETAIL OF GROUND FLOOR B1&B2	Action (2)
Location	PART(02)	Approved
Attachment	(15) A3 Sheet	Approved as Noted
		Revise and Resubmit
		Rejected

WE TRANSMIT HEREWITH / UNDER SEPARATE COVER, THE DRAWINGS,CALCULATION,ETC. LISTED BELOW.

Ser.	Drawing No.	Rev.	DESCRIPTION	SUBMITTAL CODE*	ACTION CODE **
1	SAMCO-PCO-SHD-STR-054-001	2	R.F.T DETAILS OF BOTTOM (X-DIRECTION) OF GROUND PART 2 (B1&B2)		Code / B
2	SAMCO-PCO-SHD-STR-054-002	X	R.F.T DETAILS OF DROP PANEL(X-IRECTION)OF GROUND PART 2 (B1&B2)		Code / B
3	SAMCO-PCO-SHD-STR-054-003	2	R.F.T DETAILS OF TOP(X-DIRECTION) OF GROUND PART 2 (B1&B2)		Code / B
4	SAMCO-PCO-SHD-STR-054-004	1	BBS OF R.F.T DETAILS OF BOTTOM&TOP (X-DIRECTION) OF GROUND PART 2 (B1&B2)		Code / C
5	SAMCO-PCO-SHD-STR-054-005	1	R.F.T DETAILS OF BOTTOM (Y-DIRECTION) OF GROUND PART 2 (B1&B2)		Code / B
6	SAMCO-PCO-SHD-STR-054-006	1	R.F.T DETAILS OF DROP (Y-DIRECTION) OF GROUND PART 2 (B1&B2)		Code / B
7	SAMCO-PCO-SHD-STR-054-007	1	BBS R.F.T DETAILS OF BOTTOM&DROP (Y-DIRECTION) OF.GROUND PART 2 (B1&B2)		Code / C
8	SAMCO-PCO-SHD-STR-054-008	1	R.F.T DETAILS OF TOP (Y-DIRECTION) OF GROUND PART 2 (B1&B2)		Code / B
9	SAMCO-PCO-SHD-STR-054-009	1	BBS OF R.F.T DETAILS TOP(Y-DIRECTION) OF GROUND PART 2 (B1&B2)		Code / C
10	SAMCO-PCO-SHD-STR-054-010	1	R.F.T DETAILS OF BOTTOM ADD OF GROUND PART 2 (B1&B2)		Code / B
11	SAMCO-PCO-SHD-STR-054-011	1	R.F.T DETAILS OF OPENING OF GROUND PART 2 (B1&B2)		Code / B
12	SAMCO-PCO-SHD-STR-054-012	1	BBS OF R.F.T DETAILS OF ADD BOTTOM & OPENING OF GROUND PART 2 (B1&B2)		Code / C
13	SAMCO-PCO-SHD-STR-054-013	2	R.F.T DETAILS OF ADD-TOP(X-DIRECTION) OF GROUND PART 2 (B1&B2)		Code / B
14	SAMCO-PCO-SHD-STR-054-014	2	R.F.T DETAILS OF ADD-TOP(Y-DIRECTION) OF GROUND PART 2 (B1&B2)		Code / B
15	SAMCO-PCO-SHD-STR-054-015	1	BBS OF R.F.T DETAILS ADD.TOP (Y-DIRECTION).OF.GROUND PART 2 (B1&B2)		Code / C

CONTRACTOR :		DATE :	
RECEIVED BY :		DATE :	
COPIES:			

Consultant to enter ACTION CODE and REMARKS

Supervision Consultant Remarks :

- Follow all comments stated on the attached drawing.
- IFC design drawings should be followed.
- Any modifications on concrete dimension drawings should be reflected on these drawings.
- Finally BBS quantities are subject to final approval for as built take-off
- Only coluded areas are reviewed and approved in the attached drawings

Supervision Consultant:	M.Mamdouh	DATE :	01/06/2026
-------------------------	-----------	--------	------------


Corrections or comments made relative to submittals during this review does not relieve the contractor from compliance with the requirements of the drawings and specifications. This check is only for review of general conformance with the design concept of the project and general compliance with the information given in the contract documents. The contractor is responsible for confirming and correlating all quantities and dimensions, selecting fabrication process and techniques of construction; coordinating his work with that of other trades, and performing his work in a safe and satisfactory manner.

Project Manager Remarks (If Required):

Project Manager:		DATE :	
------------------	--	--------	--

Received by Contractor:		DATE :	
-------------------------	--	--------	--

COPIES:			
+ TYPE:	SD Shop Drawings	* SUBMITTAL CODE:	** ACTION CODE:
	SM Sample	1: Submitted for Approval	A: Approved
	GT Guarantee	2: Submitted for Information	B: Approved as Noted
	MD Manufacturer's Data		C: Revise and Resubmit
	CT Certificates		D: Rejected

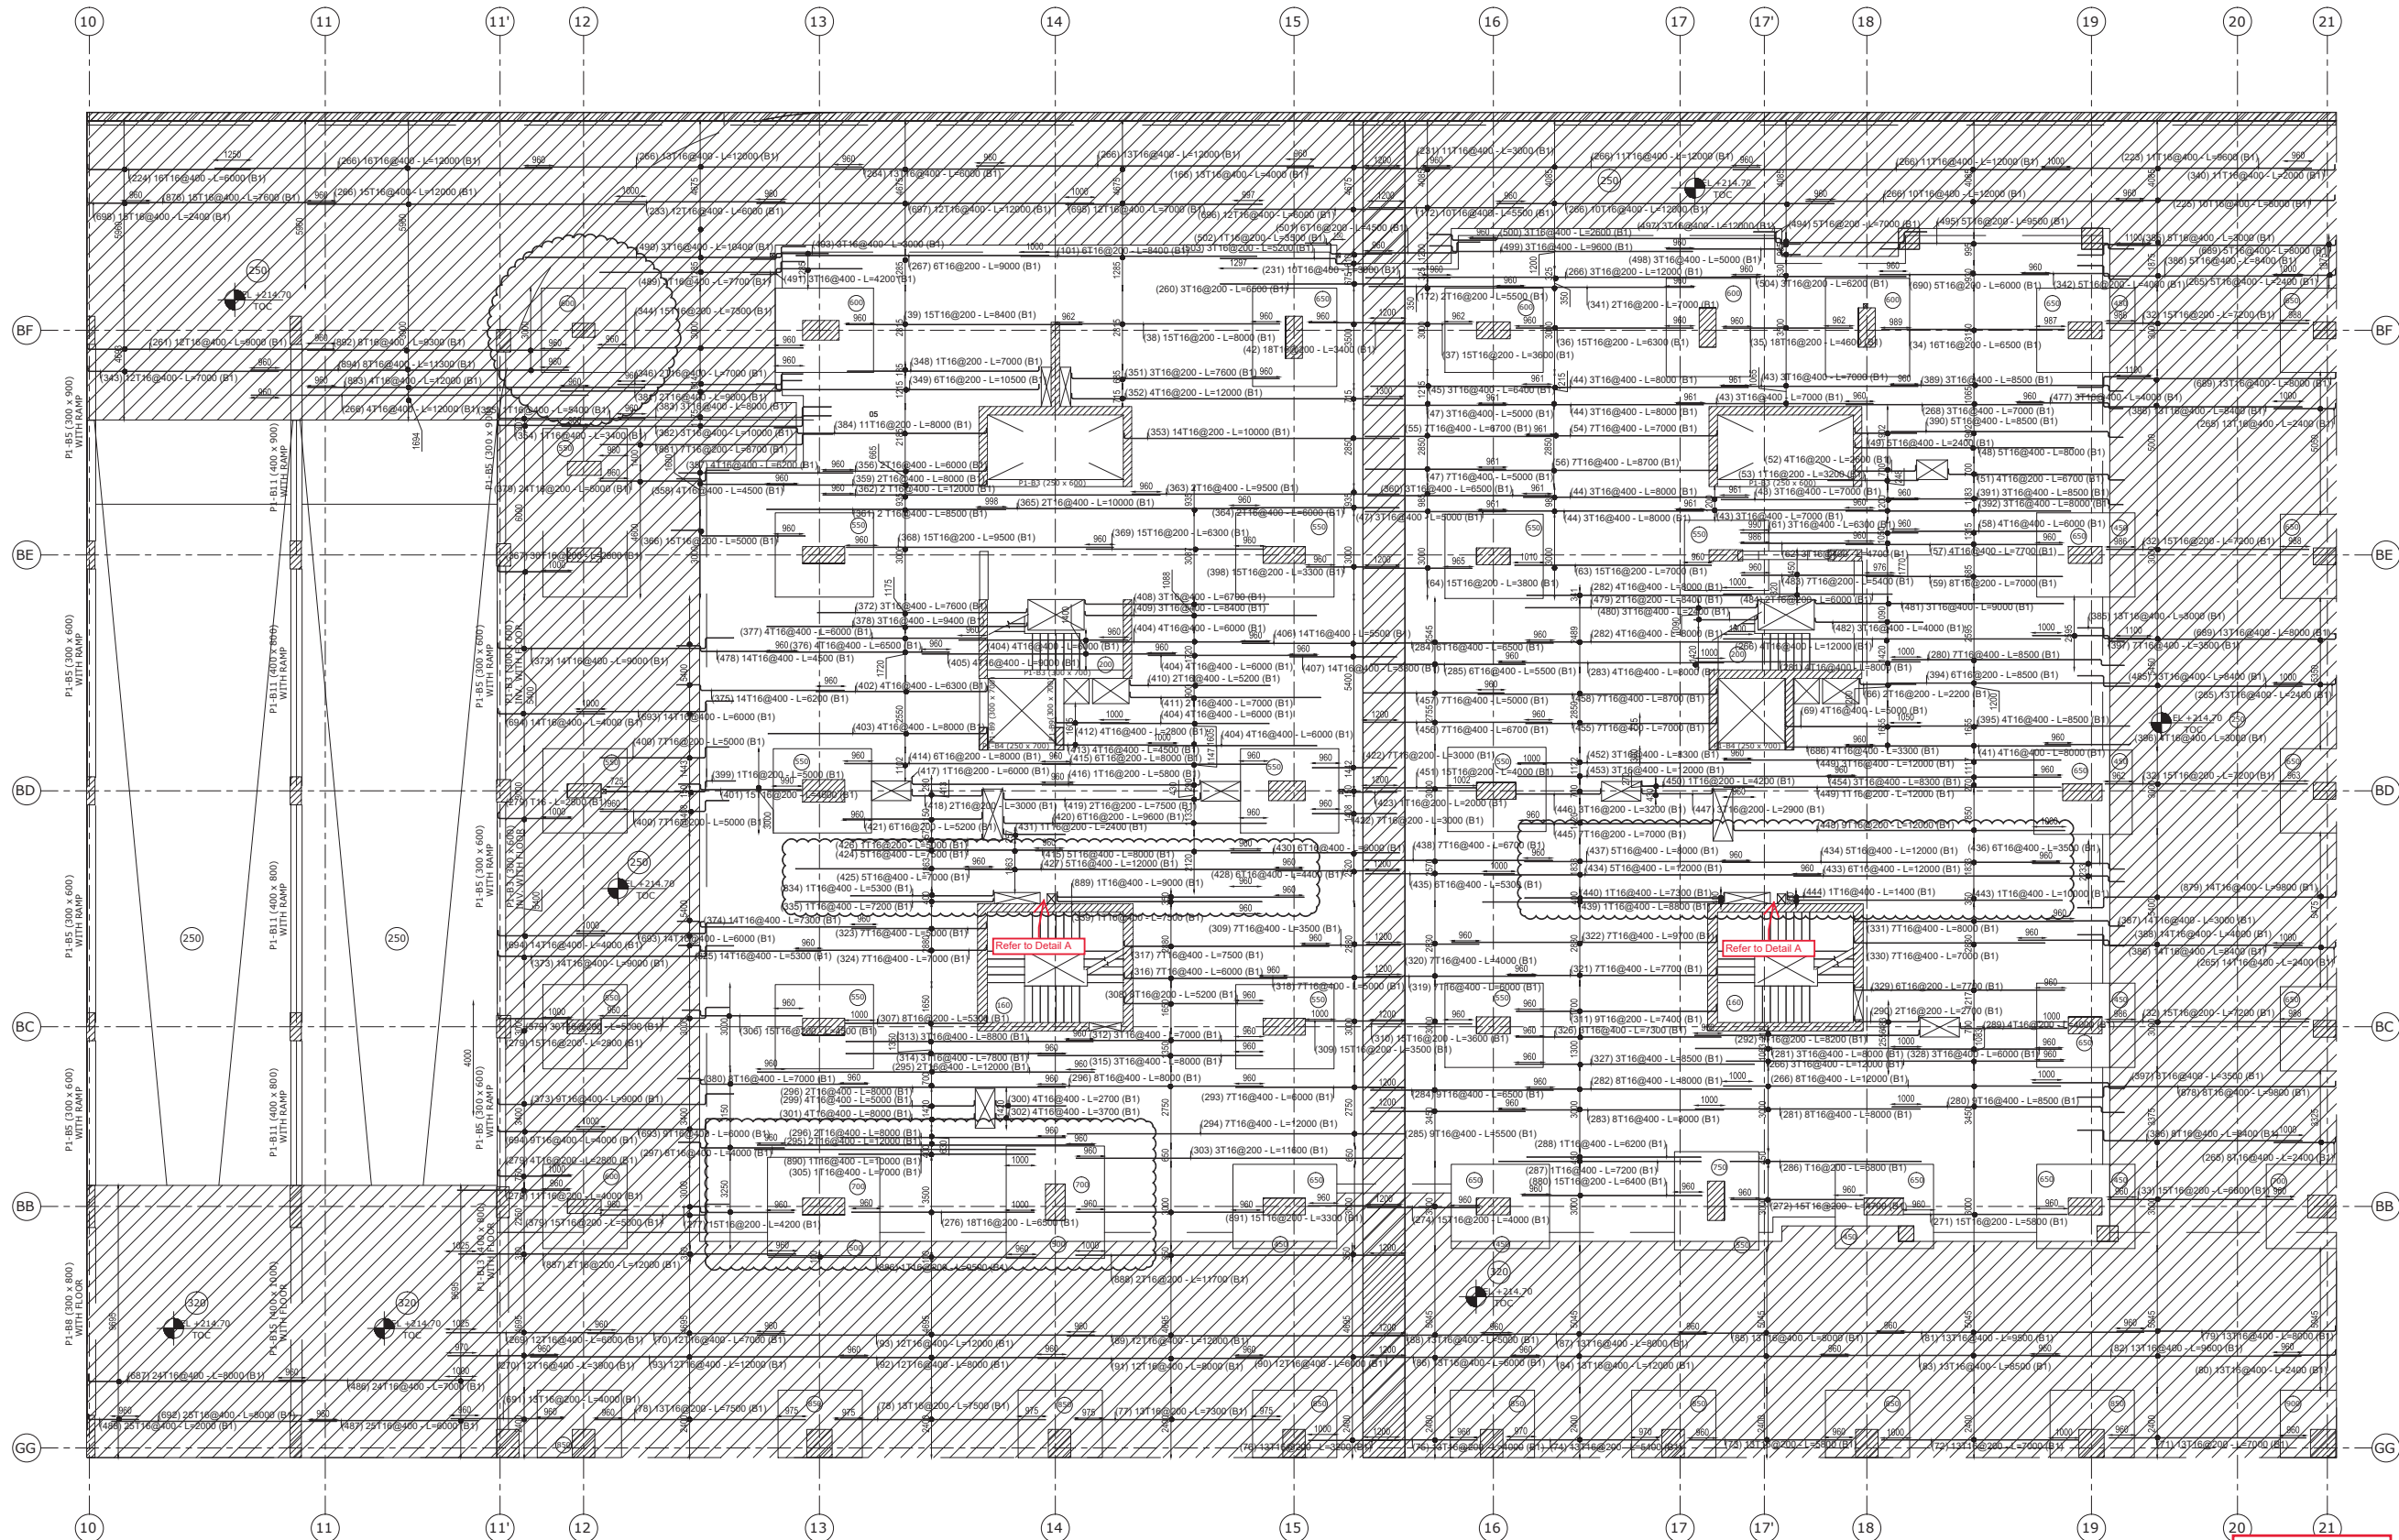

GENERAL NOTES C. CONCRETE

CONCRETE	28 DAYS CURE STRENGTH (MPa)	MINIMUM CEMENT CONTENT (kg/m³)	MINIMUM WATER CONTENT (kg/m³)	MINIMUM WATER CURE (days)
PLAIN CONCRETE (SLABING)	20	250	180	7
SLAB ON GRADE	25	300	180	7
FOUNDATION/RETAINING WALLS	25	300	180	7
RAFTER STRUCTURE	25	300	180	7

C.2. MAXIMUM AGGREGATE SIZE SHALL NOT EXCEED 20 mm.

C.3. NOMINAL COVER TO ALL REINFORCEMENT (INCLUDING LINKS) SHALL BE AS FOLLOWS (mm):

STRUCTURAL ELEMENT	mm
FOUNDATION	50 FOR ALL FACES
BEAM WALLS	30 FOR ALL FACES
RETAINING WALLS	30 EXPOSED SIDE 35 AIR SIDE
COLUMNS	30 FOR ALL FACES
SLABS	20 FOR ALL FACES

C.4. PARAMETERS AND UNITS SHALL BE CAST AFTER STRIKING FORM WORK OF SLABS AND BEAMS. CONTRACTOR TO PROVIDE COMBES FROM SLABS, BEAMS AND COLUMNS FOR PARAMETERS TO BE CAST.

C.5. ALL PRECAST CONCRETE SURFACES SHALL BE PROPERLY CURED, KEPT MOIST AND PROTECTED FROM DIRECT SUNLIGHT. CONTRACTOR SHALL BE RESPONSIBLE FOR THE PROTECTION OF THE SURFACES FROM DAMAGE DURING THE CURE PERIOD.

C.6. ALL CONSTRUCTION JOINTS OF REINFORCED CONCRETE MEMBERS SHALL BE REINFORCED OR SHALL HAVE SHEAR KEYS. IMMEDIATELY BEFORE NEW CONCRETE IS PLACED ALL CONSTRUCTION JOINTS SHALL BE KEPT CLEAN AND FREE FROM OIL AND DIRT.

C.7. ALL CONSTRUCTION JOINTS IN FLOOR SLABS SHALL BE LOCATED WITHIN THE MIDDLE THIRD OF SPAN OF SLAB. BEAMS AND GIRDERS CONSTRUCTION JOINTS IN GIRDERS SHALL BE OFFSET A MINIMUM DISTANCE OF TWO TIMES THE WIDTH OF INTERSECTING BEAMS.

C.8. WHERE CONCRETE BEAMS ARE CAST IN TWO PHASES, THE SURFACE OF PHASE 1 SHALL BE REINFORCED TO FULL AMPLITUDE OF 8 mm. THE SURFACE SHALL BE KEPT CLEAR FROM OIL AND LATEX, AND NOT.

C.9. LOCATION OF CONSTRUCTION JOINT SHALL BE SUBJECT TO THE ENGINEER'S APPROVAL.

C.10. ALL CONCRETE SHALL BE COMPACTED USING A MECHANICAL VIBRATOR.

C.11. HEAVY CONSTRUCTION EQUIPMENT AND TRUCKS ARE NOT ALLOWED TO PASS OVER THE GROUND FLOOR SLAB. CONTRACTOR SHALL TAKE ALL THE NECESSARY PRECAUTIONS TO AVOID DAMAGE TO A JOINT.

C.12. WHEN CASTING A LARGE AREA OR A LARGE VOLUME OF CONCRETE, CONTRACTOR SHALL TAKE ALL THE NECESSARY PRECAUTIONS TO AVOID OVERHEATING AND THERMAL CRACKS. SUCH AS, AND NOT LIMITED TO, CONSTRUCTION JOINTS, SHADING OF THE CAST CONCRETE AREA AND CURING.

C.13. MINIMUM PERIOD BEFORE STRIKING FORM WORK SHALL BE IN ACCORDANCE WITH ECP 203.

REV	DATE	DESCRIPTION
-----	------	-------------

02 05-2026 FOR CONSULTANT APPROVAL

01 03-2026 FOR CONSULTANT APPROVAL

00 03-2026 FOR CONSULTANT APPROVAL

REV DATE DESCRIPTION

KEY PLAN



THE BIG BUSINESS DISTRICT
New Cairo, Cairo

CLIENT:



Consultant:



Consultant:



Contractor:



DESIGN DRAWINGS REFS :

APPROVAL DATED	30-04-2026 - IFC Package (B01,B02,B03&B04) S0001 - GENERAL NOTES
----------------	--

Drawing title

R.F.T DETAILS OF BOTTOM (X-DIRECTION)
OF GROUND PART 2 (B1&B2)
SHEET (1/15)

DRAWN BY : MUSHARA EHAB STATUS FOR APPROVAL


CHECKED: Ahmed Ali DATE: 05 / 2026



APPROVED: HANY MOHSEN SCALE: 1:80

DWG. NO: SAMCO-PCO-SHD-STR-054-001-REV02


- Any modifications in concrete dimensions approved shop drawings should be reflected in these drawings.
- Splice length should be 60xDia. as per design IFC drawings
- Only colored areas are reviewed and approved in this drawing

Code / B

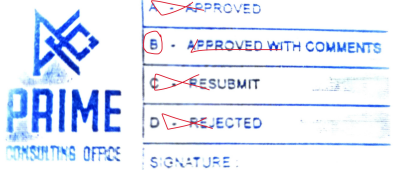

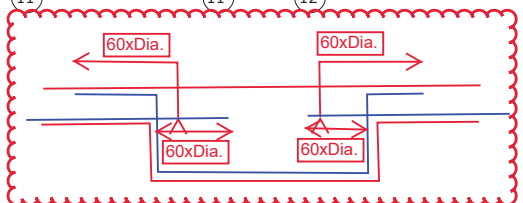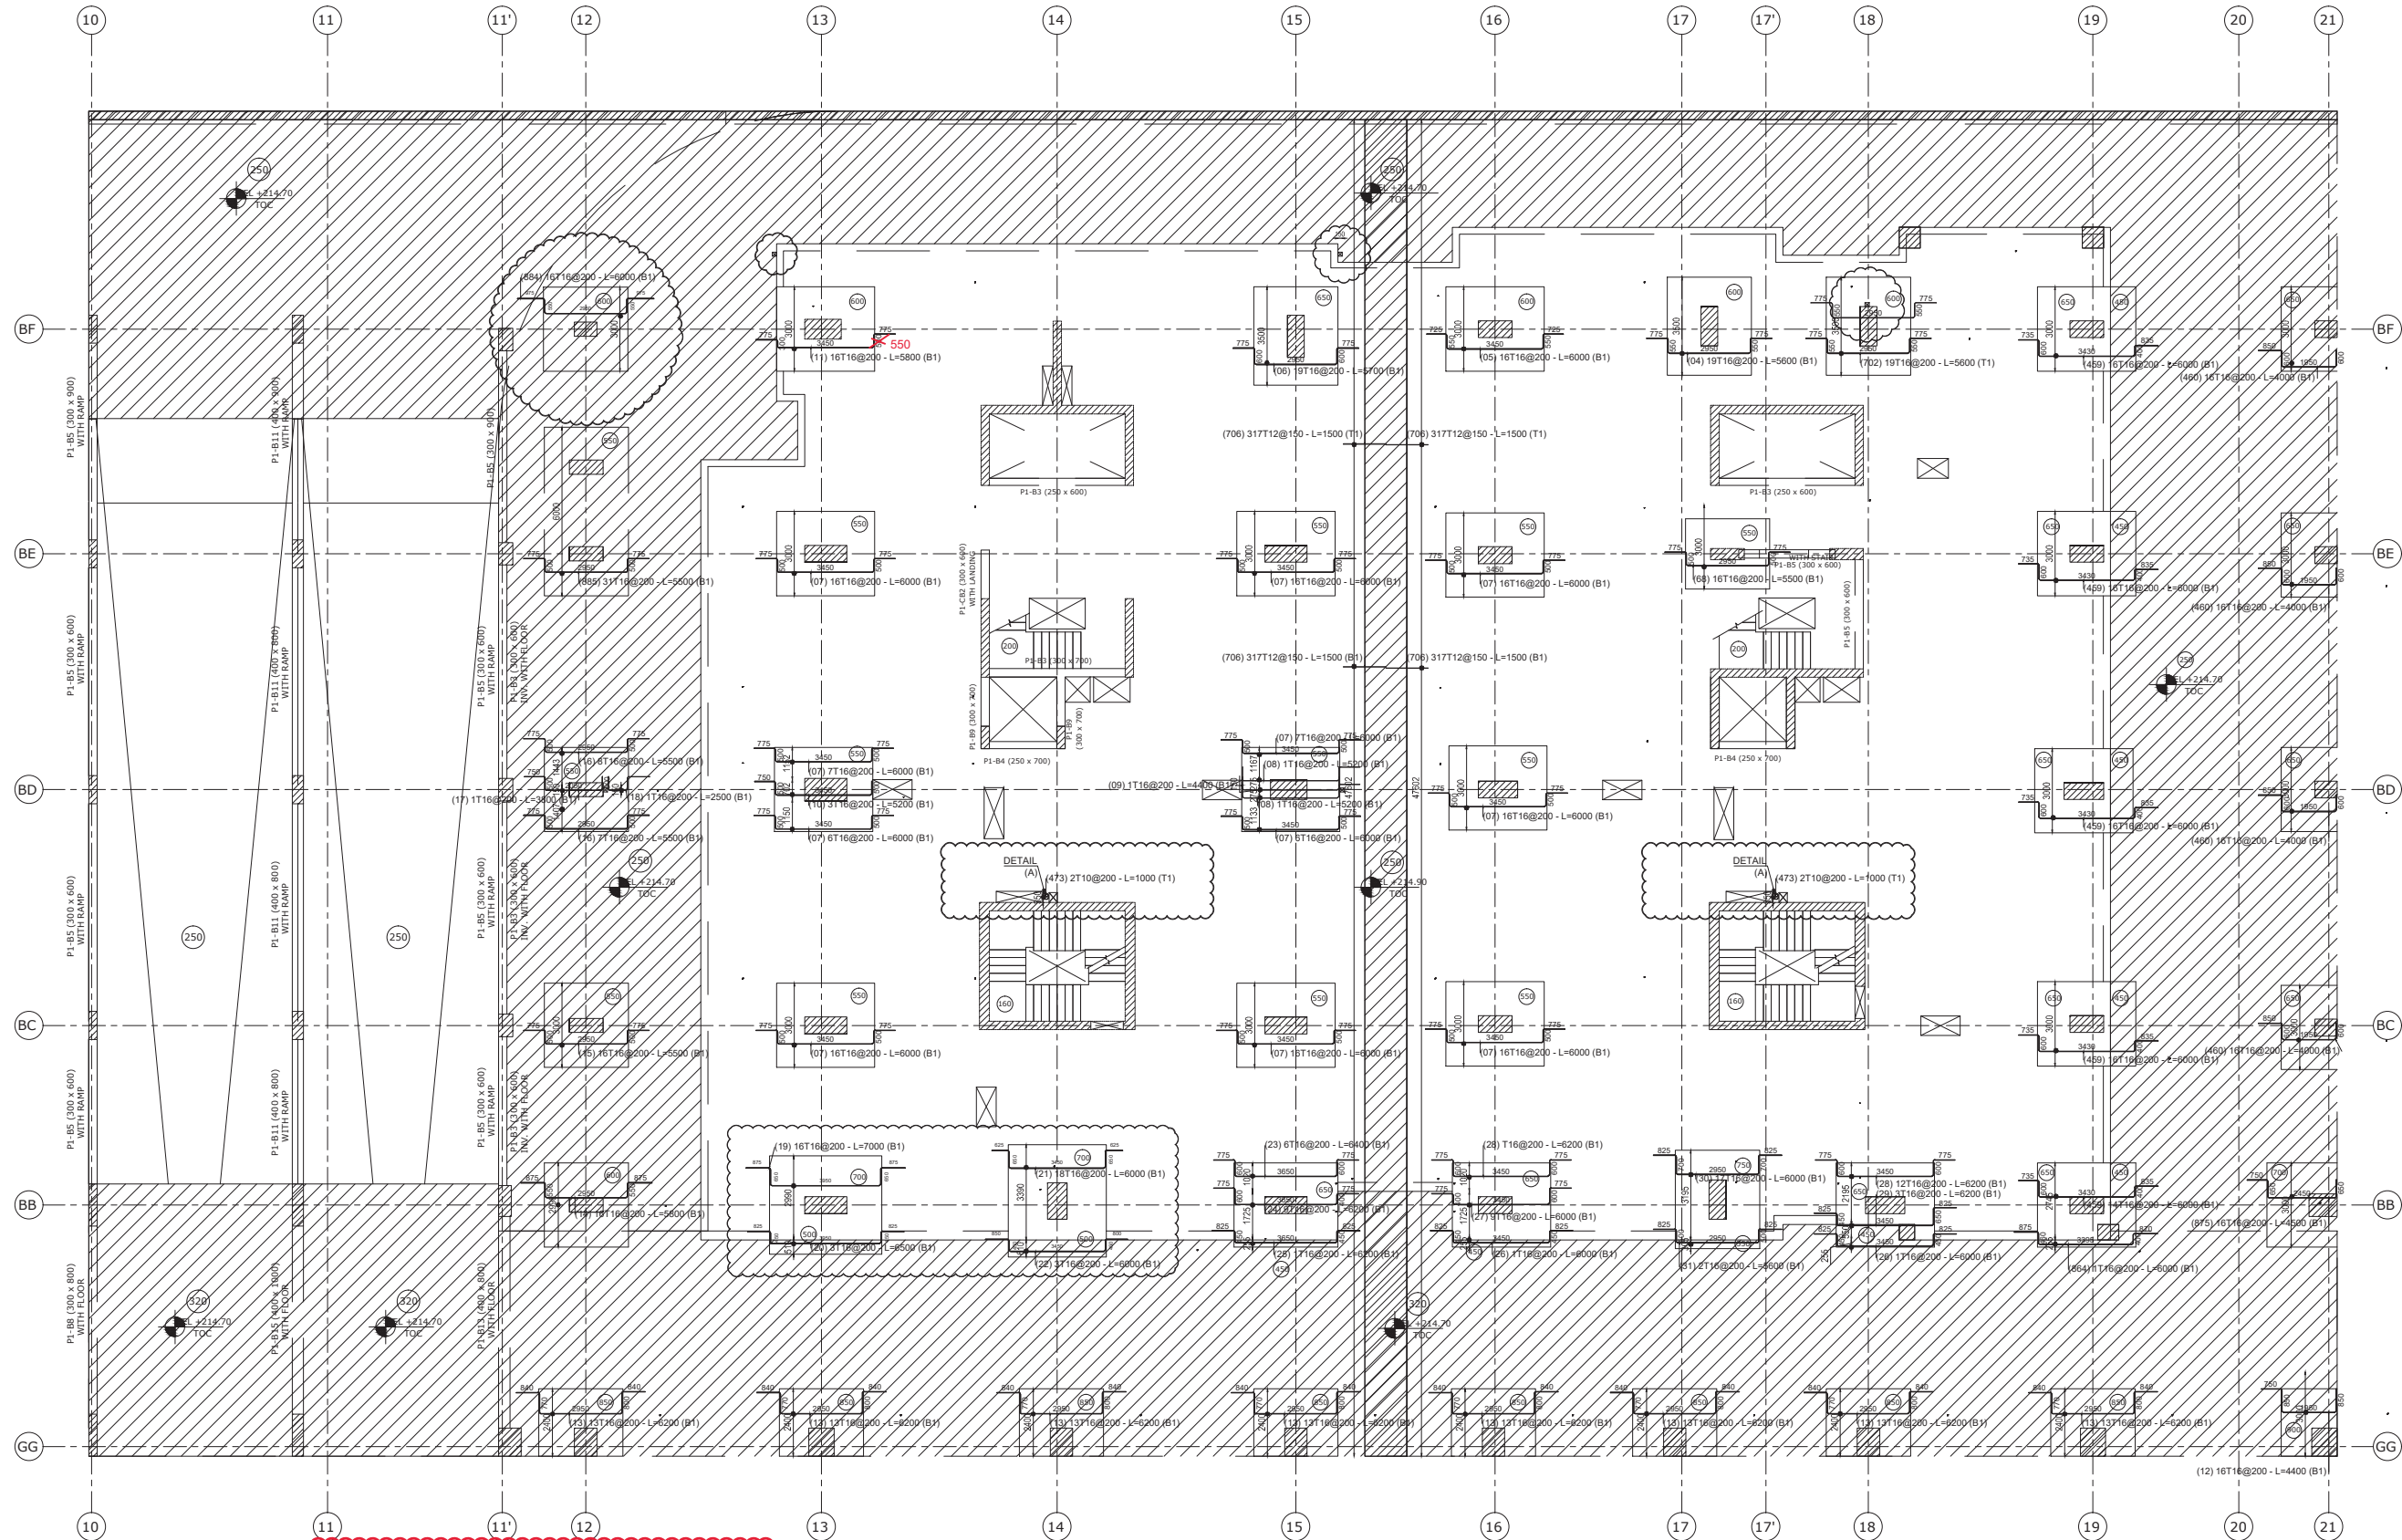

APPROVED
APPROVED WITH COMMENTS
RESUBMIT
REJECTED
SIGNATURE

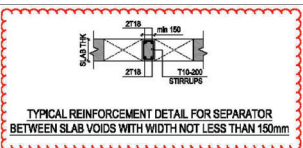

DETAIL (A)

- Any modifications in concrete dimensions approved shop drawings should be reflected in these drawings.
- Only coluded areas are reviewed and approved in this drawing

Code / B

GENERAL NOTES

C.1. CHARACTERISTIC CONCRETE COMPRESSIVE STRENGTH AT 28 DAYS SHALL BE AS FOLLOWS:

CONCRETE	TEST TYPE	MINIMUM STRENGTH	MINIMUM STRENGTH	MINIMUM STRENGTH
		MPa	MPa	MPa
PLAIN CONCRETE (SLABING)	COMPRESSIVE	25	300	0.30
SLAB ON GRADE	COMPRESSIVE	25	300	0.45
FOUNDATION/RETAINING WALLS	COMPRESSIVE	25	400	0.45
RAFTER STRUCTURE	COMPRESSIVE	25	350	0.45

C.2. MAXIMUM AGGREGATE SIZE SHALL NOT EXCEED 20 mm.

C.3. NOMINAL COVER TO ALL REINFORCEMENT (INCLUDING LINKS) SHALL BE AS FOLLOWS UNLESS SPECIFIED OTHERWISE:

STRUCTURAL ELEMENT	mm
FOUNDATION	50 FOR ALL FACES
SHEAR WALLS	50 FOR ALL FACES
RETAINING WALLS	50 FOR ALL FACES
COLUMNS	50 FOR ALL FACES
BEAMS	50 FOR ALL FACES
SLABS	25 FOR ALL FACES

C.4. PARAPETS AND LINTELS SHALL BE CAST AFTER STRIKING FORM WORK OF SLABS AND BEAMS. CONTRACTOR TO PROVIDE JOINTS FROM SLABS, BEAMS AND COLUMNS FOR PARAPETS AND LINTELS REINFORCEMENT.

C.5. ALL FRESHLY PLACED CONCRETE SURFACES SHALL BE PROPERLY CURED, KEPT MOIST AND PROTECTED FROM DIRECT SUNLIGHT.

C.6. ALL CONSTRUCTION JOINTS OF REINFORCED CONCRETE MEMBERS SHALL BE REINFORCED OR SHALL HAVE SHEAR KEYS IMMEDIATELY BEFORE NEW CONCRETE IS PLACED. ALL CONSTRUCTION JOINTS SHALL BE WETTED AND STANDING WATER REMOVED.

C.7. ALL CONSTRUCTION JOINTS IN FLOORS SHALL BE LOCATED WITHIN THE MIDDLE THIRD OF SPAN OF SLAB, BEAM AND GIRDERS. CONSTRUCTION JOINTS IN OTHERS SHALL BE LOCATED AT A MINIMUM DISTANCE OF TWO TIMES THE WIDTH OF INTERSECTING BEAMS.

C.8. WHERE CONCRETE BEAMS ARE CAST IN TWO PHASES, THE SURFACE OF PHASE 1 SHALL BE REINFORCED TO FULL AMPLITUDE OF 80 mm. THE SURFACE SHALL BE CLEAR FREE FROM DUST AND LINTES, AND NOT.

C.9. LOCATION OF CONSTRUCTION JOINT SHALL BE SUBJECT TO THE ENGINEER'S APPROVAL.

C.10. ALL CONCRETE SHALL BE COMPACTED USING A MECHANICAL VIBRATOR.

C.11. HEAVY CONSTRUCTION EQUIPMENT AND TRUCKS ARE NOT ALLOWED TO PASS OVER THE GROUND FLOOR SLAB. CONTRACTOR SHALL TAKE ALL THE NECESSARY PRECAUTIONS TO AVOID THIS CASE.

C.12. WHEN CASTING A LARGE AREA OR A LARGE VOLUME OF CONCRETE, CONTRACTOR SHALL TAKE ALL THE NECESSARY PRECAUTIONS TO AVOID SHRINKAGE AND THERMAL STRESS. SUCH AS: AIR AND NOT LIMITED TO: CONSTRUCTION JOINTS, SHRINKAGE STEEL, PRECOOLING OF CEMENT, USE OF ICE IN MIXING WATER, SHADING OF THE CAST CONCRETE AREA AND CURING.

C.13. MINIMUM PERIOD BEFORE STRIKING FORM WORK SHALL BE IN ACCORDANCE WITH ECP 203.

00 03-2026 FOR CONSULTANT APPROVAL

REV	DATE	DESCRIPTION
00	03-2026	FOR CONSULTANT APPROVAL

KEY PLAN

THE BIG BUSINESS DISTRICT
New Cairo, Cairo



Consultant

ACE-PM
MOHAMMAD BAKHOUM

Consultant

PRIME
CONSULTING OFFICE

Contractor

SAMCO
SAMCO National Construction Co.
سالمكو الوطنية للتشييد


DESIGN DRAWINGS REFS :

APPROVAL DATED 30-04-2026	30-04-2026-IFC Package (B01,B02,B03&B04) S0001-GENERAL NOTES
---------------------------	--

Drawing title

R.F.T DETAILS OF DROP PANEL(X-IRRECTION) OF GROUND PART 2 (B1&B2)
SHEET (2/15)

DRAWN BY: MUSHERA HAB	STATUS FOR APPROVAL
CHECKED: Ahmed Ali	DATE: 05 / 2026
APPROVED: HANY MOHSEN	SCALE: 1:80
DWG. NO: SAMCO-PCO-SHD-STR-054-002-REV	

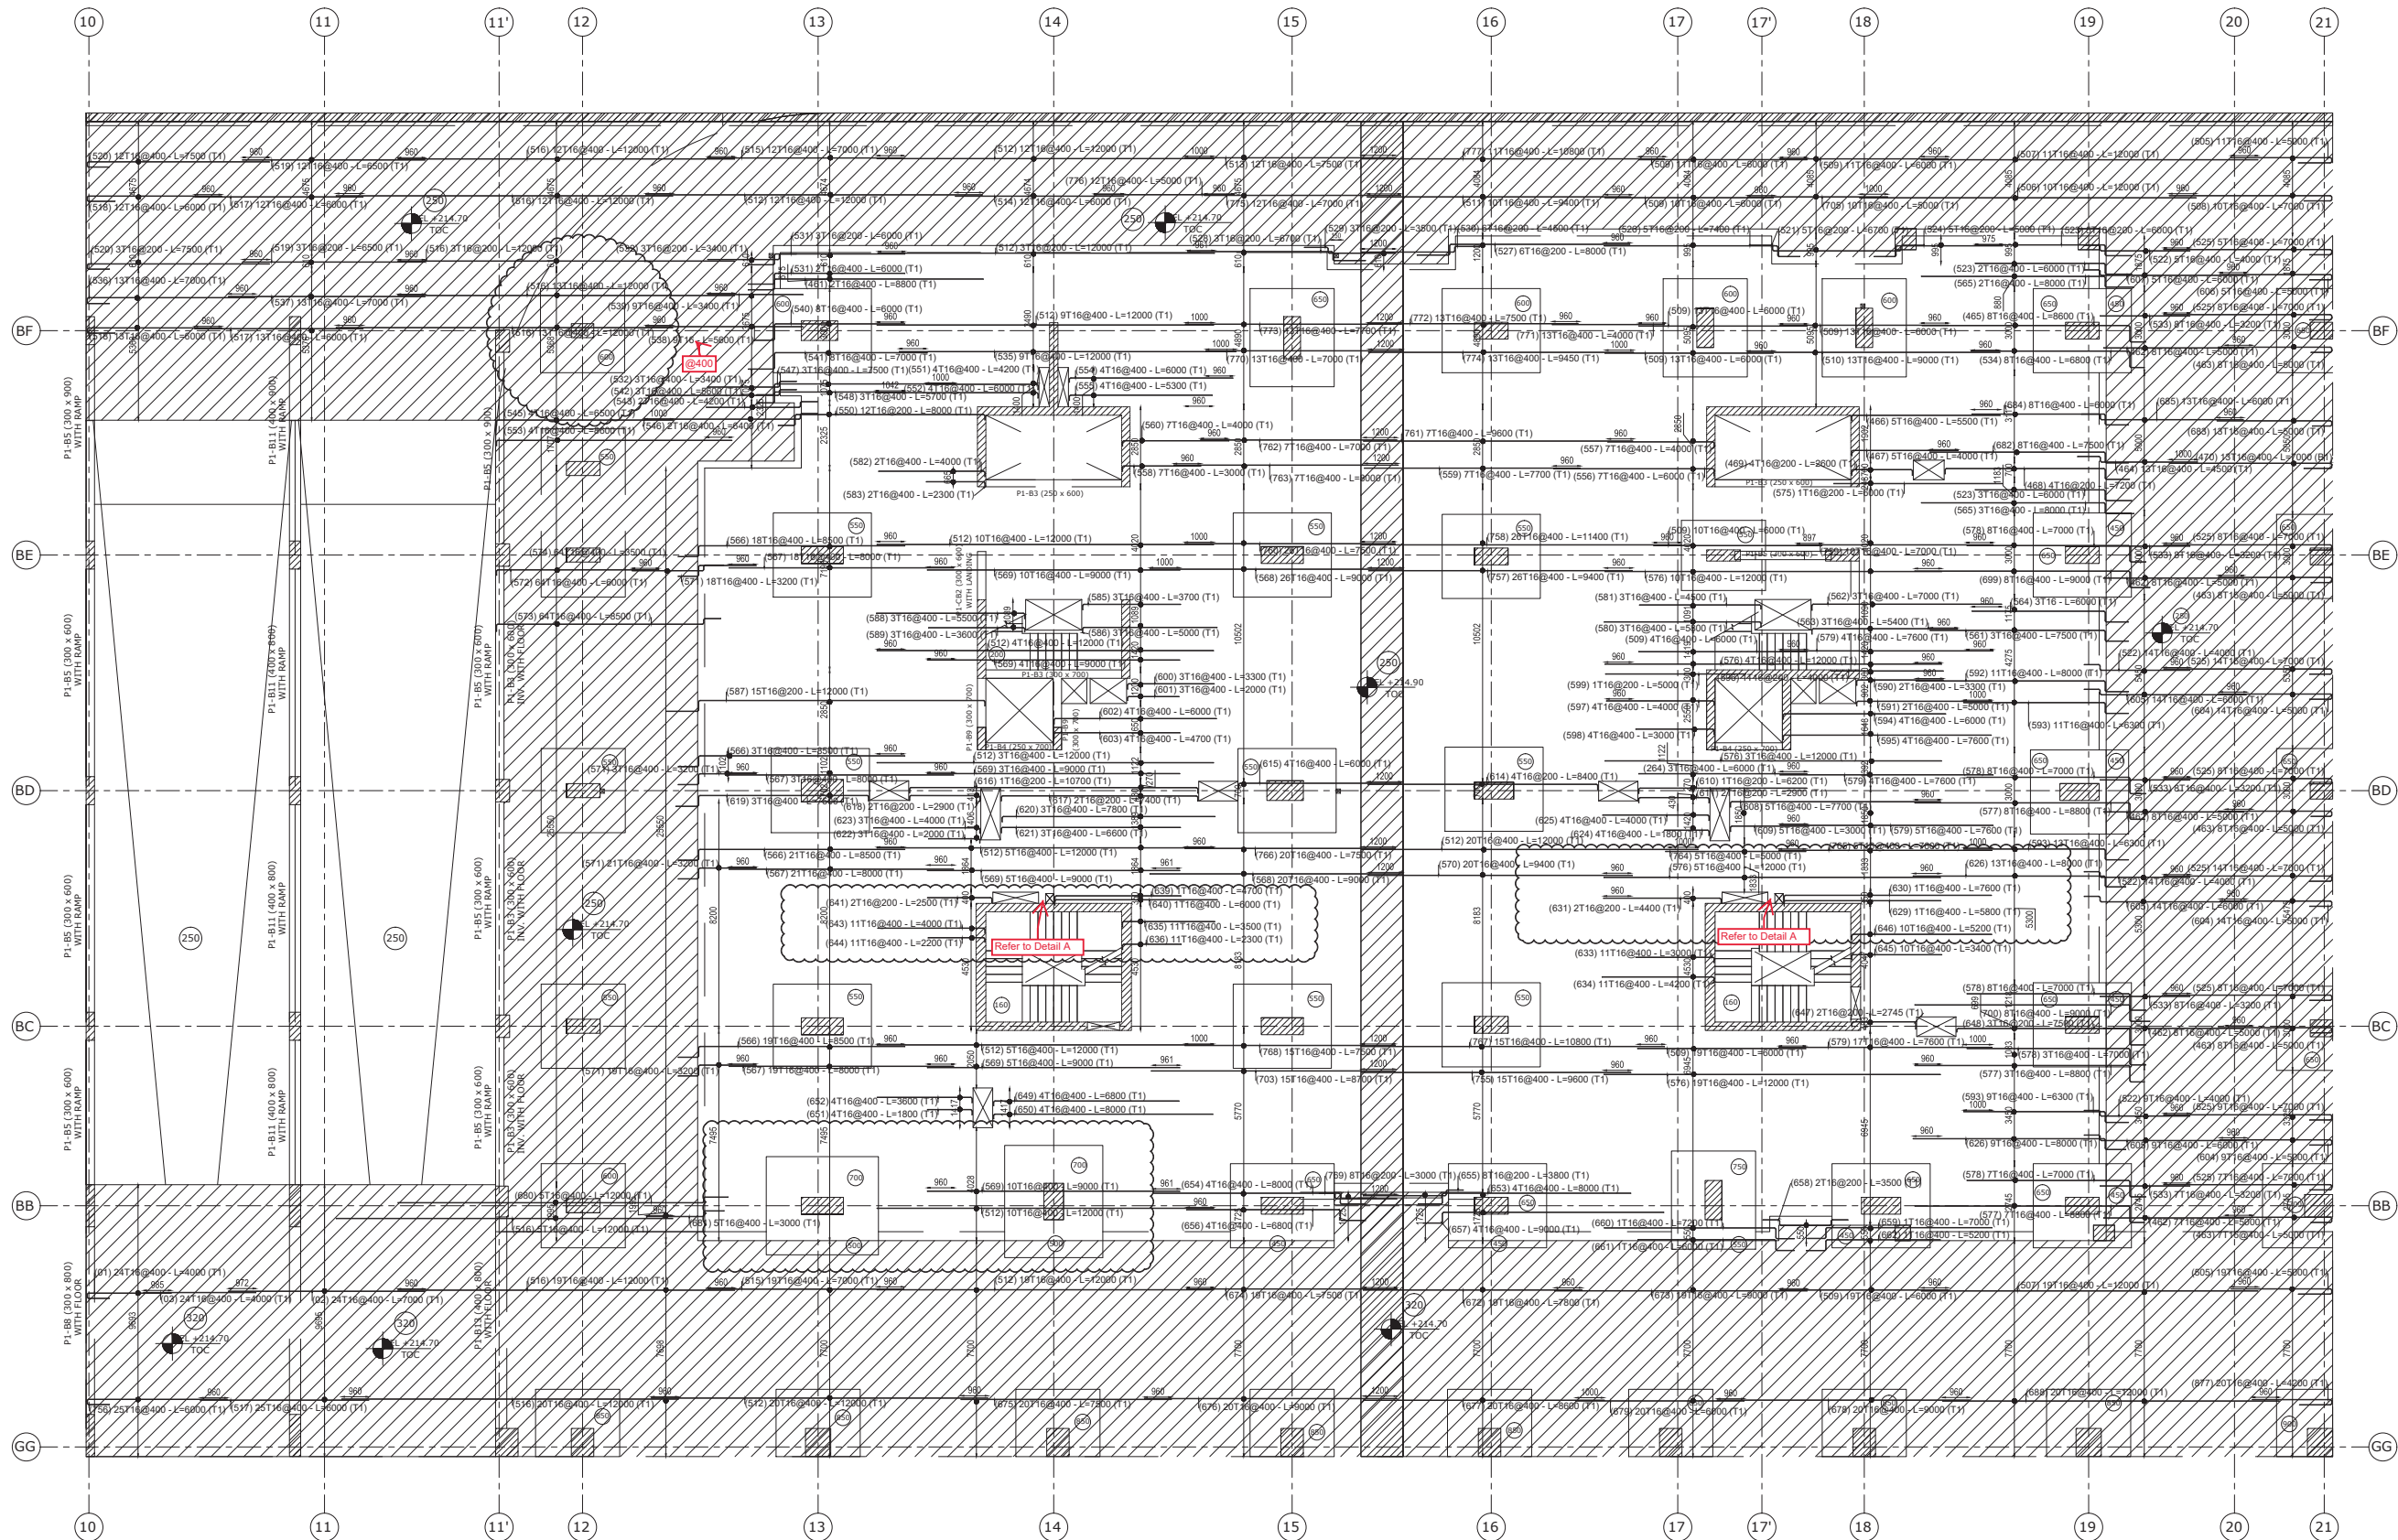

GENERAL NOTES

C. CONCRETE

CONCRETE	28 DAYS CURE STRENGTH (MPa)	MINIMUM CEMENT TYPE	MINIMUM W/C
PLAIN CONCRETE (SLABING)	25	OPC	0.45
SLAB ON GRADE	25	OPC	0.45
FOUNDATION/RETAINING WALLS	25	OPC	0.45
RAFTER STRUCTURE	25	OPC	0.45

C.2. MAXIMUM AGGREGATE SIZE SHALL NOT EXCEED 20 mm.

C.3. NOMINAL COVER TO ALL REINFORCEMENT (INCLUDING LINKS) SHALL BE AS FOLLOWS (mm):

STRUCTURAL ELEMENT	mm
FOUNDATION	50 FOR ALL FACES
BREAK WALLS	30 FOR ALL FACES
RETAINING WALLS	30 FOR ALL FACES
COLUMNS	30 FOR ALL FACES
BEAMS	30 FOR ALL FACES
SLABS	20 FOR ALL FACES

C.4. PARAPETS AND UTILITY SHALL BE CAST AFTER STRIKING FORM WORK OF SLABS AND BEAMS. CONTRACTOR TO PROVIDE DOWELS FROM SLABS, BEAMS AND COLUMNS FOR PARAPETS AND UTILITY.

C.5. ALL PRECAST CONCRETE SURFACES SHALL BE PROPERLY CURED, KEPT MOIST AND PROTECTED FROM DIRECT SUNLIGHT.

C.6. ALL CONSTRUCTION JOINTS OF REINFORCED CONCRETE MEMBERS SHALL BE REINFORCED OR SHALL HAVE SHEAR KEYS. IMMEDIATELY BEFORE NEW CONCRETE IS PLACED ALL CONSTRUCTION JOINTS SHALL BE PREPARED AND REINFORCED.

C.7. ALL CONSTRUCTION JOINTS IN FLOORS SHALL BE LOCATED WITHIN THE MIDDLE THIRD OF SPANS OF SLABS, BEAMS, AND GIRDERS. CONSTRUCTION JOINTS IN GIRDERS SHALL BE PLACED AT A MINIMUM DISTANCE OF TWO TIMES THE WIDTH OF INTERSECTING BEAMS.

C.8. WHERE CONCRETE BEAMS ARE CAST IN TWO PHASES, THE SURFACE OF PHASE 1 SHALL BE REINFORCED TO FULL AMPLITUDE OF 8 mm. SURFACE SHALL BE CLEAR FREE FROM DUST AND LATTICE, AND SET.

C.9. LOCATION OF CONSTRUCTION JOINT SHALL BE SUBJECT TO THE ENGINEER'S APPROVAL.

C.10. ALL CONCRETE SHALL BE COMPACTED USING A MECHANICAL VIBRATOR.


C.11. HEAVY CONSTRUCTION EQUIPMENT AND TRUCKS ARE NOT ALLOWED TO PASS OVER THE GROUND FLOOR SLAB. CONTRACTOR SHALL TAKE ALL THE NECESSARY PRECAUTIONS TO AVOID OVERLOADING.

C.12. WHEN CASTING A LARGE AREA OR A LARGE VOLUME OF CONCRETE, CONTRACTOR SHALL TAKE ALL THE NECESSARY PRECAUTIONS TO AVOID OVERLOADING AND THERMAL CRACKS. SUCH AS, BUT NOT LIMITED TO, CONSTRUCTION JOINTS, INTERNAL STIFFENERS, REDUCTION OF CEMENT, USE OF ICE IN MIXING WATER, SHADING OF THE CAST CONCRETE AREA AND CURING.

C.13. MINIMUM PERIOD BEFORE STRIKING FORM WORK SHALL BE IN ACCORDANCE WITH ECP 308.

REV	DATE	DESCRIPTION
01	03-2026	FOR CONSULTANT APPROVAL
00	03-2026	FOR CONSULTANT APPROVAL

KEY PLAN

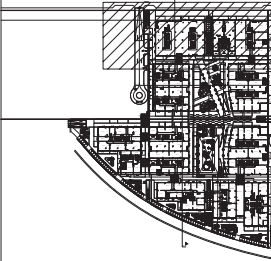

THE BIG BUSINESS DISTRICT
New Cairo, Cairo

CLIENT:



Consultant:



Consultant:



Contractor:



DESIGN DRAWINGS REFS :

APPROVAL DATED 30-04-2026	30-04-2026 - IFC Package (B01,B02,B03&B04)
	S0001 - GENERAL NOTES

Drawing title

R.F.T DETAILS OF TOP(X-DIRECTION)
OF GROUND PART 2 (B1&B2)
SHEET (3/15)

DRAWN BY : MUSHARA EHAB	STATUS FOR APPROVAL
CHECKED : Ahmed Ali	DATE: 05 / 2026
APPROVED : HANY MOHSEN	SCALE: 1:80

DWG. NO: SAMCO-PCO-SHD-SHT-054-003-REV02




APPROVED
APPROVED WITH COMMENTS
RESUBMIT
REJECTED
SIGNATURE

- Any modifications in concrete dimensions approved shop drawings should be reflected in these drawings.
- Splice length should be 60xDia. as per design IFC drawings
- Only coluded areas are reviewed and approved in this drawing

Code / B

Elements				Number		Total		Mass	
Name	Num	DIA.	Length (mm)	In the element	total	Total Length (mm)	(kg)	Total mass (kg)	
32	16	7200.0	15	60	432000.0	852.56			
33	16	6600.0	15	15	99000.0	56.42			
34	16	6500.0	16	16	104000.0	64.33			
35	16	4600.0	18	18	82800.0	130.82			
36	16	8300.0	15	15	94500.0	149.31			
37	16	3600.0	15	15	54000.0	85.32			
38	16	8000.0	15	15	120000.0	189.60			
39	16	8400.0	15	15	126000.0	199.70			
41	16	8000.0	4	4	32000.0	50.56			
42	16	3400.0	18	18	61200.0	96.70			
43	16	7000.0	12	12	84000.0	132.72			
44	16	8000.0	12	12	96000.0	151.68			
45	16	4400.0	15	15	19200.0	30.34			
46	16	5000.0	13	13	65000.0	102.70			
47	16	8000.0	5	5	40000.0	63.20			
48	16	2400.0	5	5	12000.0	18.96			
49	16	6700.0	4	4	26800.0	42.34			
52	16	2600.0	4	4	10400.0	16.43			
53	16	3200.0	1	1	3200.0	5.06			
54	16	7000.0	7	7	49000.0	77.42			
55	16	6700.0	7	7	46900.0	74.10			
56	16	8700.0	7	7	60900.0	96.22			
57	16	7700.0	4	4	30800.0	48.66			
58	16	6000.0	4	4	24000.0	37.92			
59	16	7000.0	8	8	56000.0	88.48			
61	16	6200.0	3	3	18600.0	29.86			
62	16	4700.0	3	3	14100.0	22.28			
63	16	7000.0	15	15	105000.0	165.90			
64	16	3800.0	15	15	57000.0	90.06			
66	16	2200.0	2	2	4400.0	6.95			
69	16	5000.0	4	4	20000.0	31.60			
70	16	7000.0	12	12	84000.0	132.72			
71	16	7000.0	13	13	91000.0	143.78			
72	16	7000.0	13	13	91000.0	143.78			
73	16	5800.0	13	13	75400.0	119.13			
74	16	5400.0	13	13	70200.0	110.92			
75	16	4000.0	13	13	52000.0	82.16			
76	16	3200.0	13	13	41600.0	65.73			
77	16	7300.0	13	13	94900.0	149.94			
78	16	7500.0	26	26	195000.0	308.11			
79	16	8000.0	13	13	104000.0	164.33			
80	16	2400.0	13	13	31200.0	49.30			
81	16	9500.0	13	13	123500.0	195.13			
82	16	9600.0	13	13	124800.0	197.18			
83	16	8500.0	13	13	110500.0	174.59			
84	16	8000.0	13	13	104000.0	164.33			
85	16	8000.0	13	13	104000.0	164.33			
86	16	6000.0	13	13	78000.0	123.24			
87	16	8000.0	13	13	104000.0	164.33			
88	16	5000.0	13	13	65000.0	102.70			
89	16	12000.0	12	12	144000.0	227.53			
90	16	6000.0	12	12	72000.0	113.76			
91	16	8000.0	12	12	96000.0	151.68			
92	16	3200.0	12	12	38400.0	60.43			
93	16	12000.0	24	24	288000.0	455.08			
101	16	8400.0	6	6	50400.0	79.63			
116	16	4000.0	13	13	52000.0	82.16			
127	16	5500.0	12	12	66000.0	104.25			
223	16	9600.0	11	11	105600.0	166.85			
224	16	6000.0	16	16	96000.0	151.68			
225	16	8000.0	10	10	80000.0	126.43			
231	16	3000.0	21	21	63000.0	99.54			
233	16	6000.0	12	12	72000.0	113.76			
260	16	6500.0	3	3	19500.0	30.81			
261	16	9000.0	12	12	108000.0	170.64			
264	16	6000.0	13	13	78000.0	123.24			
265	16	2400.0	53	53	127200.0	200.98			
266	16	12000.0	121	121	1452000.0	2294.16			
267	16	9000.0	6	6	54000.0	85.32			
268	16	7000.0	3	3	21000.0	33.18			
269	16	6000.0	12	12	72000.0	113.76			
270	16	3900.0	12	12	46800.0	73.94			
271	16	5800.0	15	15	87000.0	137.46			
272	16	4700.0	15	15	70500.0	111.33			
274	16	4000.0	15	15	60000.0	94.80			
276	16	6500.0	18	18	117000.0	184.86			
277	16	4200.0	15	15	63000.0	99.54			
278	16	4000.0	11	11	44000.0	69.42			
279	16	2800.0	20	20	56000.0	88.58			
280	16	8500.0	16	16	136000.0	214.88			
281	16	8000.0	15	15	120000.0	189.60			
282	16	8000.0	16	16	128000.0	202.24			
283	16	8000.0	12	12	96000.0	151.68			
284	16	6500.0	15	15	97500.0	154.05			
285	16	5500.0	15	15	82500.0	130.35			
286	16	6800.0	1	1	6800.0	10.78			
287	16	7200.0	1	1	7200.0	11.38			
288	16	6200.0	1	1	6200.0	9.80			
289	16	4000.0	4	4	16000.0	25.28			
290	16	7200.0	2	2	14400.0	22.52			
292	16	8200.0	1	1	8200.0	12.96			
293	16	6000.0	7	7	42000.0	66.36			
294	16	12000.0	7	7	84000.0	132.72			
295	16	12000.0	4	4	48000.0	75.84			
296	16	8000.0	12	12	96000.0	151.68			
297	16	4000.0	8	8	32000.0	50.56			
299	16	5000.0	4	4	20000.0	31.60			
300	16	2700.0	4	4	10800.0	17.06			
301	16	8000.0	4	4	32000.0	50.56			
302	16	3700.0	4	4	14800.0	23.38			
303	16	11600.0	3	3	34800.0	54.98			
305	16	7000.0	1	1	7000.0	11.06			
306	16	4500.0	15	15	67500.0	106.63			
307	16	5300.0	8	8	42400.0	66.99			
308	16	5200.0	8	8	41600.0	65.73			
309	16	3500.0	2	2	7000.0	11.06			
310	16	3600.0	15	15	54000.0	85.32			
311	16	7400.0	9	9	66600.0	105.23			
312	16	7000.0	3	3	21000.0	33.18			
313	16	8800.0	3	3	26400.0	41.71			
314	16	7800.0	3	3	23400.0	36.97			
315	16	8000.0	3	3	24000.0	37.92			
316	16	6000.0	7	7	42000.0	66.36			
317	16	7500.0	7	7	52500.0	82.93			
318	16	5000.0	7	7	35000.0	55.30			
319	16	6000.0	7	7	42000.0	66.36			
320	16	4000.0	7	7	28000.0	44.24			
321	16	7000.0	7	7	49000.0	77.42			
322	16	9700.0	7	7	67900.0	107.28			
323	16	5000.0	7	7	35000.0	55.30			
324	16	7000.0	7	7	49000.0	77.42			
325	16	5300.0	14	14	74200.0	117.24			
326	16	7300.0	3	3	21900.0	34.60			
327	16	8500.0	3	3	25500.0	40.29			
328	16	6000.0	3	3	18000.0	28.44			
329	16	7700.0	6	6	46200.0	73.02			
330	16	7000.0	6	6	42000.0	66.36			
331	16	8000.0	7	7	56000.0	88.48			
334	16	5300.0	1	1	5300.0	8.37			
335	16	7200.0	1	1	7200.0	11.38			
339	16	7500.0	1	1	7500.0	11.85			
340	16	2000.0	11	11	22000.0	34.76			
341	16	7000.0	2	2	14000.0	22.12			
342	16	4000.0	5	5	20000.0	31.60			
343	16	7000.0	12	12	84000.0	132.72			
344	16	7300.0	15	15	109500.0	173.01			
346	16	7000.0	2	2	14000.0	22.12			
348	16	7000.0	1	1	7000.0	11.06			
349	16	10500.0	6	6	63000.0	99.54			
351	16	7600.0	3	3	22800.0	36.02			
352	16	12000.0	4	4	48000.0	75.84			
353	16	10000.0	14	14	140000.0	221.25			
354	16	3400.0	1	1	3400.0	5.32			
355	16	5400.0	1	1	5400.0	8.53			
356	16	6000.0	2	2	12000.0	18.96			
357	16	6200.0	4	4	24800.0	39.65			
358	16	4500.0	4	4	18000.0	28.44			
359	16	4500.0	2	2	9000.0	14.22			
360	16	6500.0	2	2	13000.0	20.46			
361	16	8500.0	2	2	17000.0	26.89			
362	16	12000.0	2	2	24000.0	37.92			
363	16	9500.0	2	2	19000.0	30.02			
364	16	6000.0	2	2	12000.0	18.96			
365	16	10000.0	2	2	20000.0	31.60			

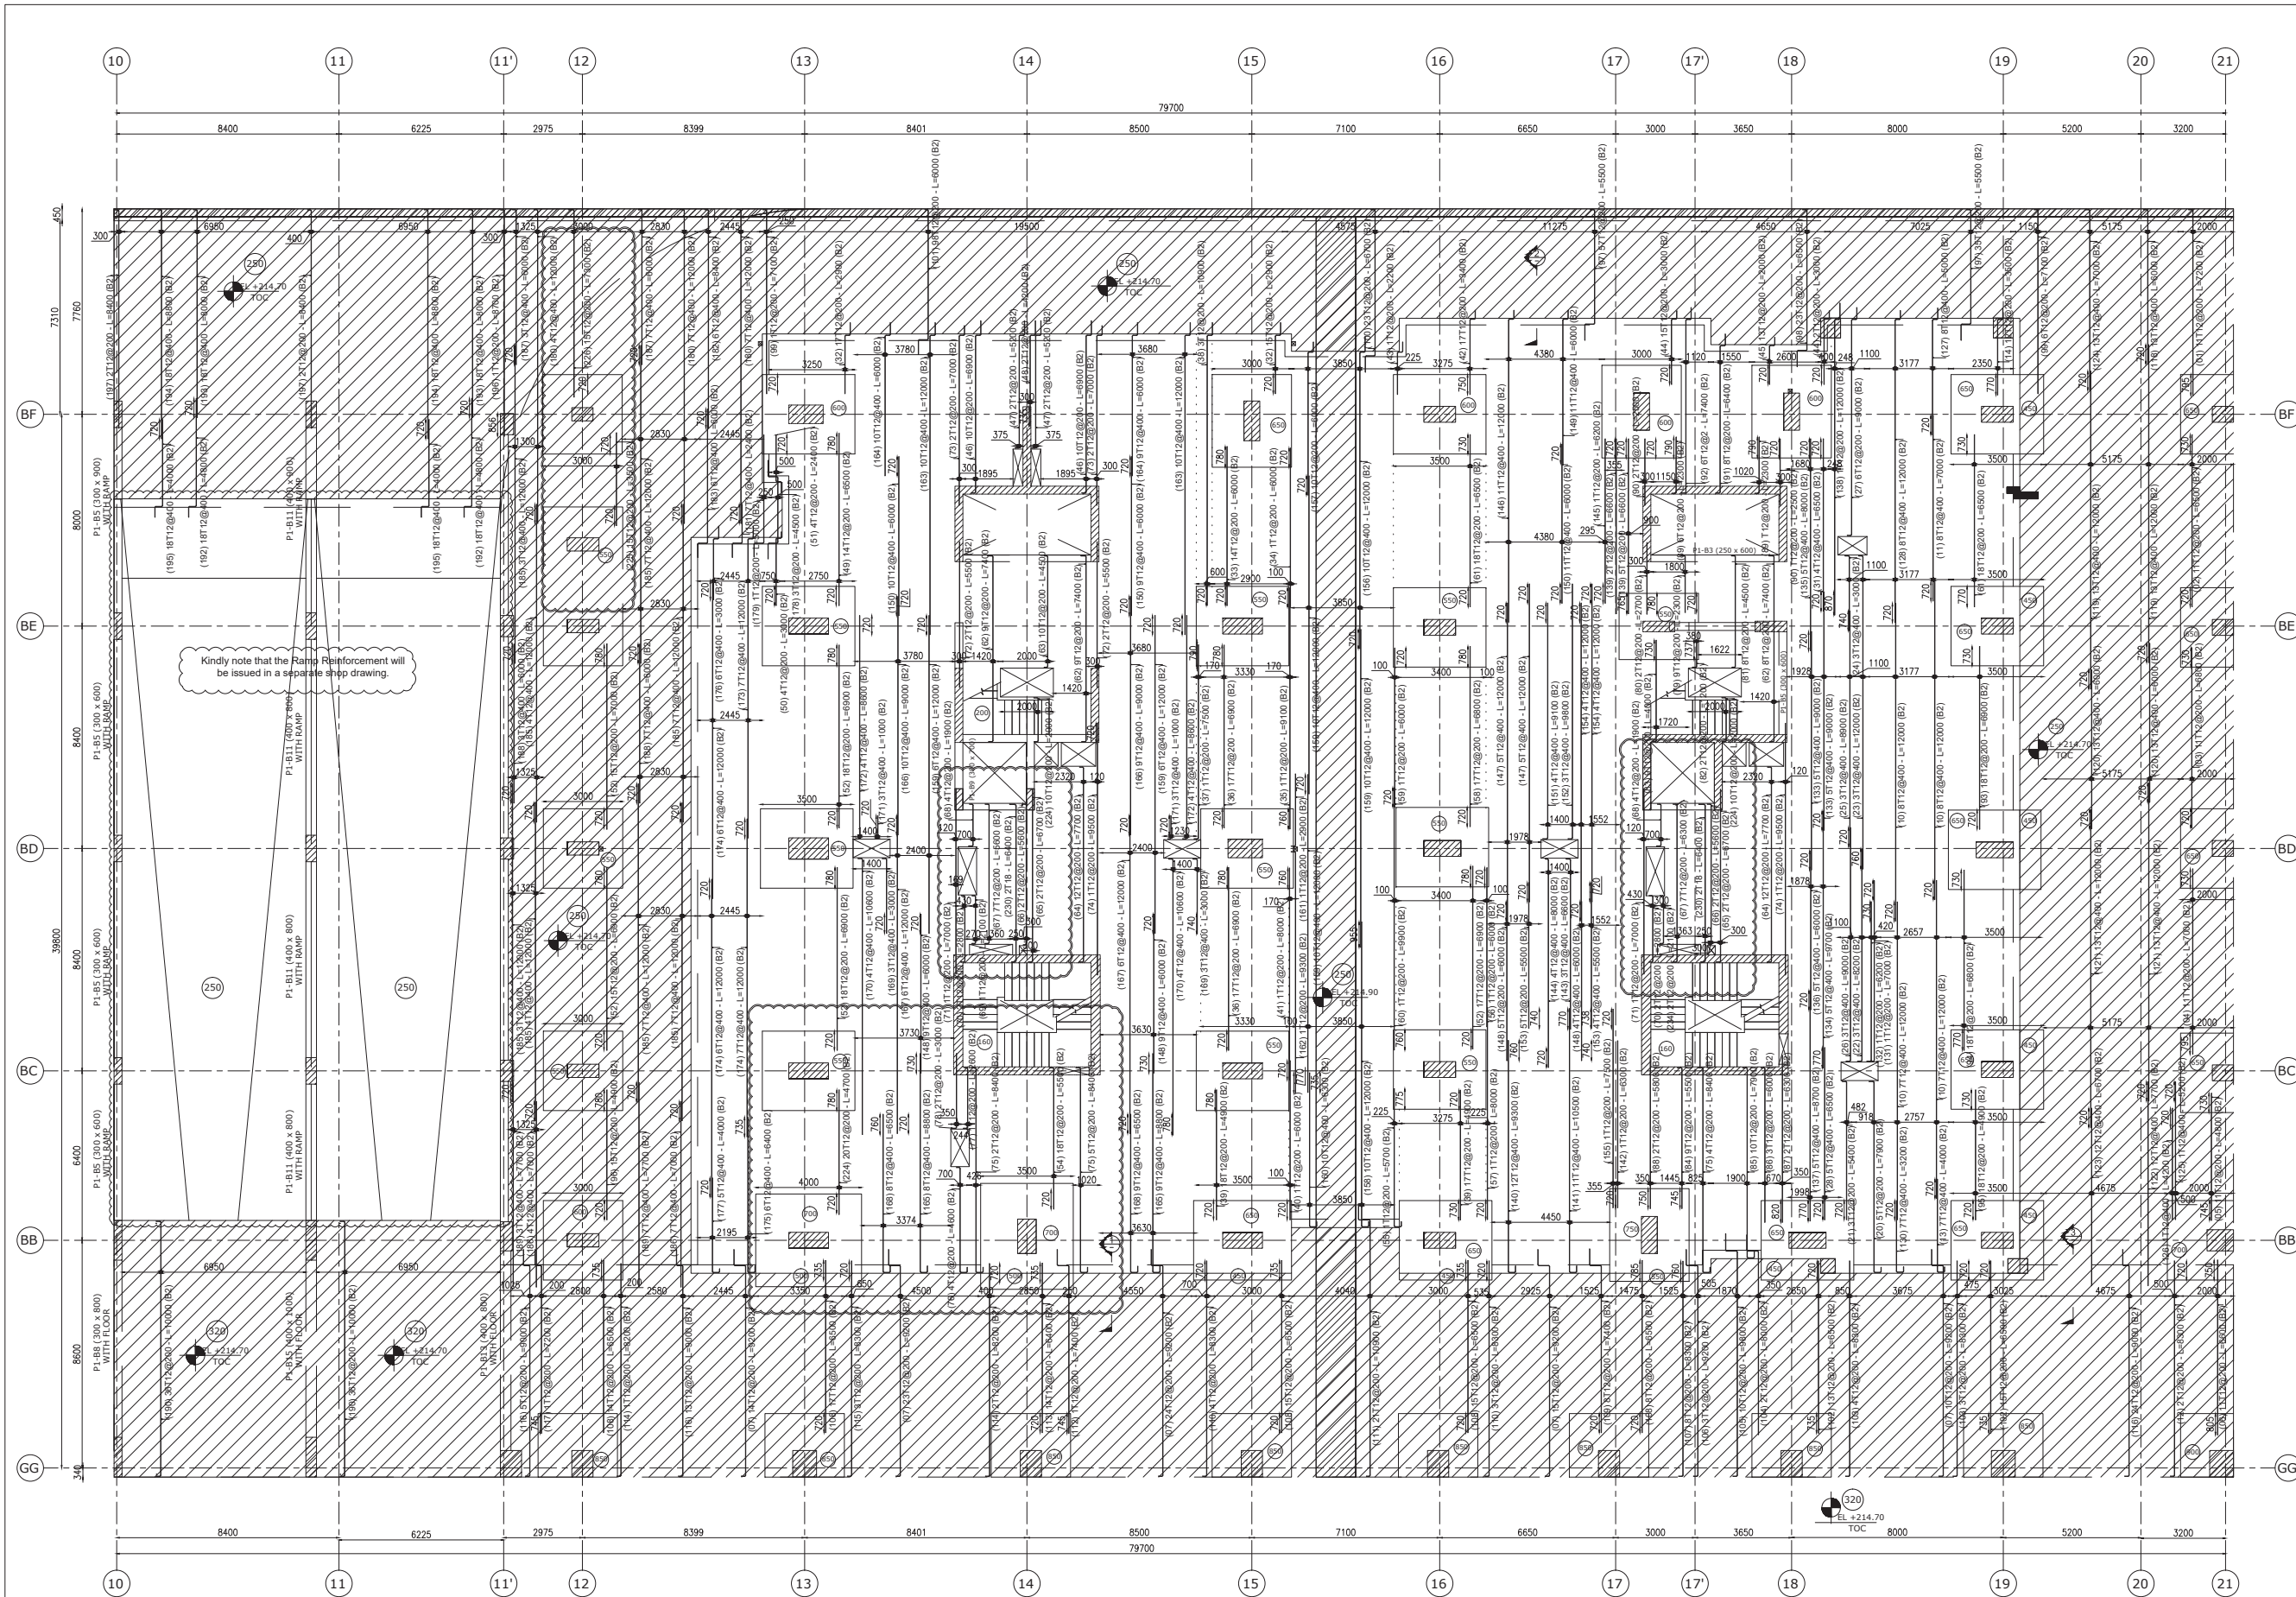

- GENERAL NOTES**
- C. CONCRETE**
- C.1. CHARACTERISTIC CONCRETE COMPRESSIVE STRENGTH AT 28 DAYS SHALL BE AS FOLLOWS:
- | CONCRETE | 28 DAYS COMPRESSION STRENGTH (MPa) | MINIMUM CEMENT TYPE | MAXIMUM W/C |
|----------------------------|------------------------------------|---------------------|-------------|
| PLAIN CONCRETE / FINISHING | 25 | OPC | 0.50 |
| SLAB ON GRADE | 25 | OPC | 0.45 |
| FOUNDATION/RETAINING WALLS | 25 | OPC | 0.45 |
| RAFTER STRUCTURE | 25 | OPC | 0.45 |
- C.2. MAXIMUM AGGREGATE SIZE SHALL NOT EXCEED 20 mm.
- C.3. NOMINAL COVER TO ALL REINFORCEMENT (INCLUDING LINKS) SHALL BE AS FOLLOWS (mm):
- | STRUCTURAL ELEMENT | mm |
|--------------------|------------------|
| FOUNDATION | 50 FOR ALL FACES |
| BEAR WALLS | 30 FOR ALL FACES |
| RETAINING WALLS | 30 FOR ALL FACES |
| COLUMNS | 30 FOR ALL FACES |
| BEAMS | 30 FOR ALL FACES |
| SLABS | 20 FOR ALL FACES |
- C.4. FORMWORK AND LINTLS SHALL BE CAST AFTER STRIKING FORM WORK OF SLABS AND BEAR. CONTRACTOR TO PROVIDE DOWELS FROM SLABS, BEARS AND COLUMNS FOR FORMWORK AND LINTLS REINFORCEMENT.
- C.5. ALL FRESHLY PLACED CONCRETE SURFACES SHALL BE PROPERLY CURED, KEPT MOIST AND PROTECTED FROM DIRECT SUNLIGHT.
- C.6. ALL CONSTRUCTION JOINTS OF REINFORCED CONCRETE MEMBERS SHALL BE REINFORCED OR SHALL HAVE BEAR REIN. IMMEDIATELY BEFORE NEW CONCRETE IS PLACED ALL CONSTRUCTION JOINTS SHALL BE KEPT CLEAN AND PROPERLY WATER REMOVED.
- C.7. ALL CONSTRUCTION JOINTS IN FLOORS SHALL BE LOCATED WITHIN THE MIDDLE THIRD OF SPAN OF SLAB, BEARS, AND GIRDERS. CONSTRUCTION JOINTS IN GIRDERS SHALL BE OFFSET A MINIMUM DISTANCE OF TWO TIMES THE WIDTH OF INTERSECTING BEARS.
- C.8. WHERE CONCRETE BEARS ARE CAST IN TWO PHASES, THE SURFACE OF PHASE 1 SHALL BE REINFORCED TO FULL AMPLITUDE OF 10 mm. THE SURFACE SHALL BE KEPT FREE FROM DUST AND LINTLS, AND SET.
- C.9. LOCATION OF CONSTRUCTION JOINT SHALL BE SUBJECT TO THE ENGINEER'S APPROVAL.
- C.10. ALL CONCRETE SHALL BE COMPACTED USING A MECHANICAL VIBRATOR.
- C.11. HEAVY CONSTRUCTION EQUIPMENT AND TRUCKS ARE NOT ALLOWED TO PASS OVER THE GROUND FLOOR SLAB. CONTRACTOR SHALL TAKE ALL THE NECESSARY PRECAUTIONS TO AVOID OVERLOADING.
- C.12. WHEN CASTING A LARGE AREA OF CONCRETE, CONTRACTOR SHALL TAKE ALL THE NECESSARY PRECAUTIONS TO AVOID OVERLOADING AND THERMAL CRACKS. SUCH AS, AND NOT LIMITED TO, CONSTRUCTION JOINTS, SHADING OF THE CAST CONCRETE AREA, AND CURING.
- C.13. MINIMUM PERIOD BEFORE STRIKING FORM WORK SHALL BE IN ACCORDANCE WITH ECP 203.



01	05-2026	FOR CONSULTANT APPROVAL
00	03-2026	FOR CONSULTANT APPROVAL
REV	DATE	DESCRIPTION
KEY PLAN		
THE BIG BUSINESS DISTRICT New Cairo, Cairo		

CLIENT:	
Consultant:	
Consultant:	
Contractor:	


DESIGN DRAWINGS REFS :	
APPROVAL DATED 30-04-2026	30-04-2026 - IFC Package (B01,B02,B03&B04) S0001-GENERAL NOTES

Drawing title	
R.F.T DETAILS OF BOTTOM (Y-DIRECTION) OF GROUND PART 2 (B1&B2) SHEET (5/15)	

DRAWN BY : MUSHARA HAHAB	STATUS FOR APPROVAL
CHECKED: Ahmed Ali	DATE: 05 / 2026
APPROVED: HANY MOHSEN	SCALE: 1:80
DWG. NO: SAMCO-PCO-SHD-STR-054-005-REV01	

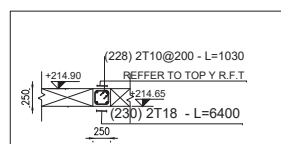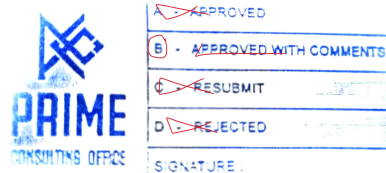


DETAIL (A)

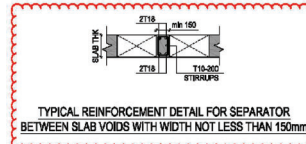

- Any modifications in concrete dimensions approved shop drawings should be reflected in these drawings.
- Splice length should be 60xDia. as per design IFC drawings
- Only coluted areas are reviewed and approved in this drawing

Code / B

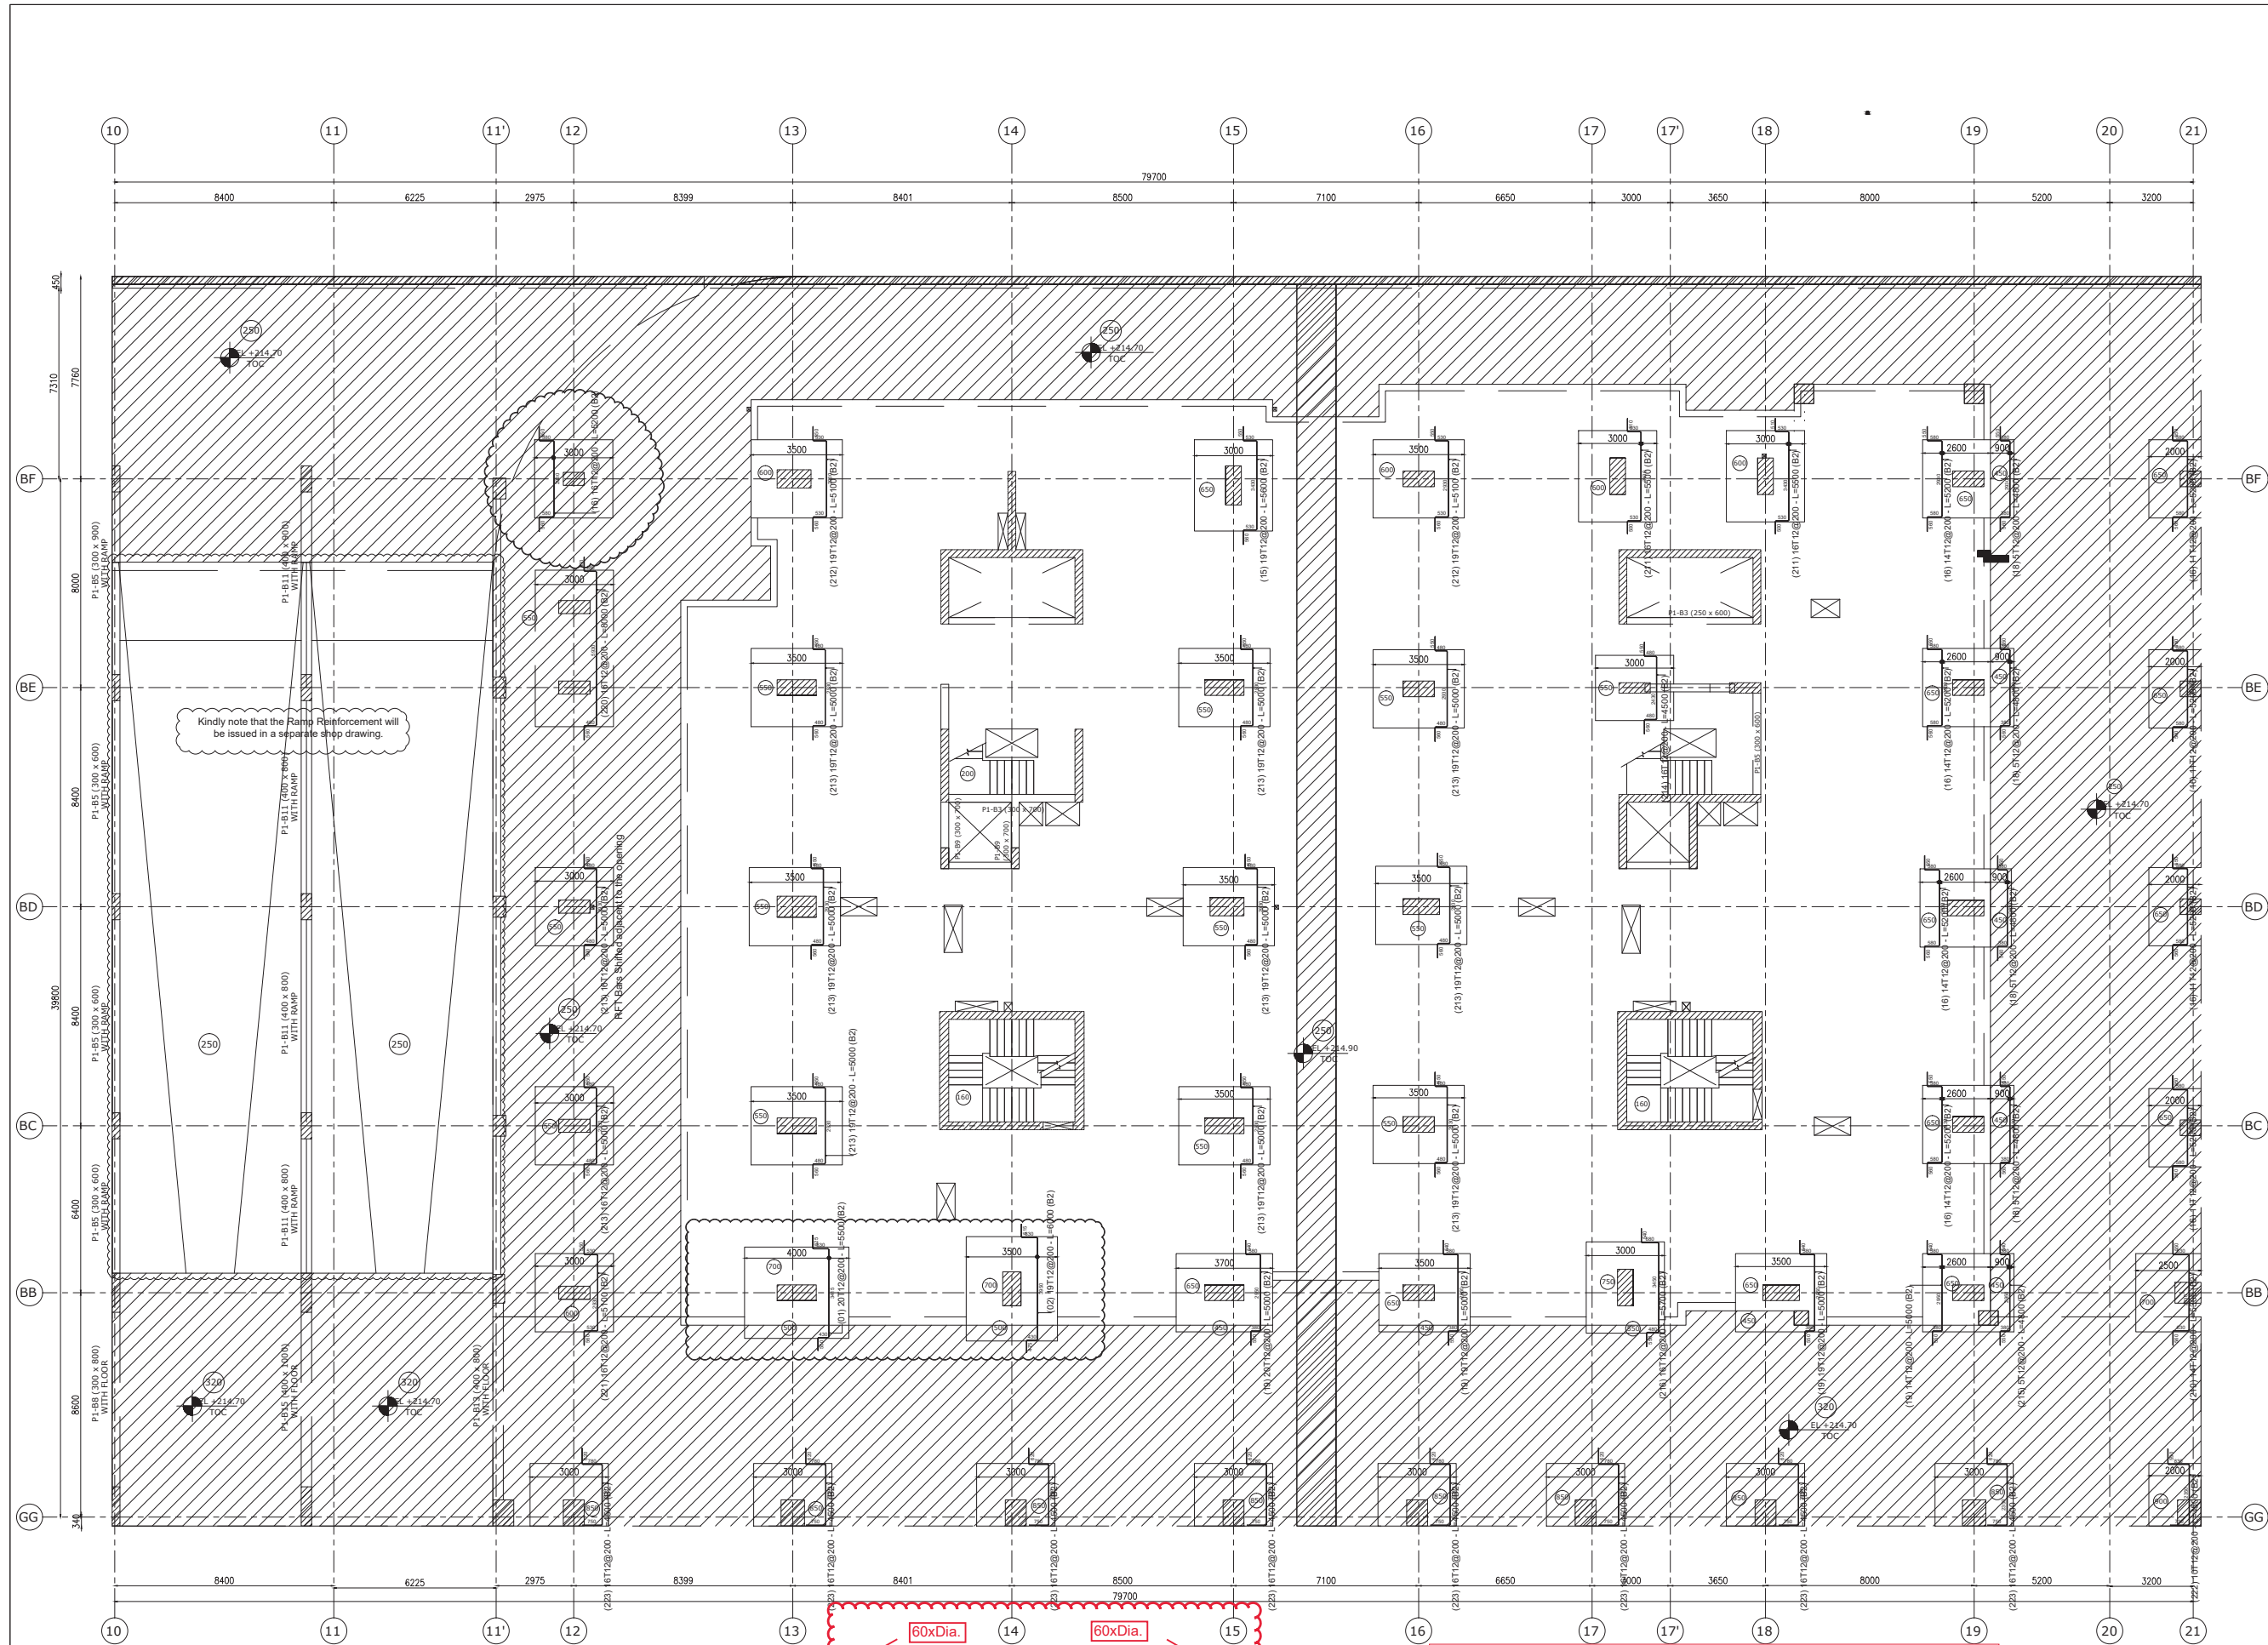

GENERAL NOTES

C. CONCRETE

C.1. CHARACTERISTIC CONCRETE COMPRESSIVE STRENGTH AT 28 DAYS SHALL BE AS FOLLOWS:

CONCRETE	28 DAYS CUBE STRENGTH (N/mm ²)	MINIMUM CEMENT RATIO	CEMENT TYPE	MAXIMUM W/C
PLAIN CONCRETE (SLABING)	25	300	OPC	0.50
SLAB ON GRADE	25	300	OPC	0.45
FOUNDATION/RETAINING WALLS	25	400	OPC	0.45
SUPER STRUCTURE	25	300	OPC	0.45

C.2. MAXIMUM AGGREGATE SIZE SHALL NOT EXCEED 20 mm.

C.3. NOMINAL COVER TO ALL REINFORCEMENT (INCLUDING LINKS) SHALL BE AS FOLLOWS (mm):

STRUCTURAL ELEMENT	mm
FOUNDATION	50 FOR ALL FACES
BEARING WALLS	30 FOR ALL FACES
RETAINING WALLS	30 EXPOSED SIDE 35 AIR SIDE
COLUMNS	30 FOR ALL FACES
BEAMS	30 FOR ALL FACES
SLABS	20 FOR ALL FACES

C.4. PARAPETS AND LINTELS SHALL BE CAST AFTER STRIKING FORM WORK OF SLABS AND BEAMS. CONTRACTOR TO PROVIDE DOWELS FROM SLABS, BEAMS AND COLUMNS FOR PARAPETS AND LINTEL REINFORCEMENT.

C.5. ALL FRESHLY PLACED CONCRETE SURFACES SHALL BE PROPERLY CURED, KEPT MOIST AND PROTECTED FROM DIRECT SUNLIGHT.

C.6. ALL CONSTRUCTION JOINTS OF REINFORCED CONCRETE MEMBERS SHALL BE REINFORCED OR SHALL HAVE SHEAR KEYS. IMMEDIATELY BEFORE NEW CONCRETE IS PLACED ALL CONSTRUCTION JOINTS SHALL BE WETTED AND STANDING WATER REMOVED.

C.7. ALL CONSTRUCTION JOINTS IN FLOORS SHALL BE LOCATED WITHIN THE MIDDLE THIRD OF SPAN OF SLABS, BEAMS AND GIRDERS. CONSTRUCTION JOINTS IN GIRDERS SHALL BE OFFSET A MINIMUM DISTANCE OF TWO TIMES THE WIDTH OF INTERSECTING BEAMS.

C.8. WHERE CONCRETE BEAMS ARE CAST IN TWO PHASES, THE SURFACE OF PHASE 1 SHALL BE REINFORCED TO FULL AMPLITUDE OF 10 mm. THE SURFACE SHALL BE KEPT FREE FROM DUST AND LATTICE, AND SET.

C.9. LOCATION OF CONSTRUCTION JOINT SHALL BE SUBJECT TO THE ENGINEER'S APPROVAL.

C.10. ALL CONCRETE SHALL BE COMPACTED USING A MECHANICAL VIBRATOR.

C.11. NEAR CONSTRUCTION EQUIPMENT AND TRUCKS ARE NOT ALLOWED TO PASS OVER THE GROUND FLOOR SLAB. CONTRACTOR SHALL TAKE ALL THE NECESSARY PRECAUTIONS TO AVOID DAMAGE TO A SLAB.

C.12. WHEN CASTING A LARGE AREA OR A LARGE VOLUME OF CONCRETE, CONTRACTOR SHALL TAKE ALL THE NECESSARY PRECAUTIONS TO AVOID SHRINKAGE AND THERMAL STRESS. SUCH AS, AND NOT LIMITED TO, CONSTRUCTION JOINTS, SHADING OF THE CAST CONCRETE AREA AND CURING.

C.13. MINIMUM PERIOD BEFORE STRIKING FORM WORK SHALL BE IN ACCORDANCE WITH IS:1893.

REV	DATE	DESCRIPTION
01	05-2026	FOR CONSULTANT APPROVAL
00	03-2026	FOR CONSULTANT APPROVAL

KEY PLAN

THE BIG BUSINESS DISTRICT
New Cairo, Cairo

CLIENT:

ROYA DEVELOPMENTS

Consultant:

ACE-PM
MOHARRAM BAKHOUM

Consultant:

PRIME
CONSULTING OFFICE

Contractor:

SAMCO
SAMCO National Construction Co.
شركة سامكو الوطنية للبناء

DESIGN DRAWINGS REFS :

30-04-2026 -IFC Package
APPROVAL DATED 30-04-2026 (801.B02.B03&B04)
50001-GENERAL NOTES

Drawing title


R.F.T DETAILS OF DROP (Y-DIRECTION) OF GROUND PART 2 (B1&B2)
SHEET (6/15)

DRAWN BY: MUSERA E HAB	STATUS FOR APPROVAL
CHECKED: Ahmed Ali	DATE: 05 / 2026
APPROVED: HANY MOHSEN	SCALE: 1:80
DWG. NO: SAMCO-PCO-SHD-STR-054-006-REV01	

Code / B


Elements		POS.	DIA.	Length (mm)	Number In the element	Total Length (mm)	Mass (kg)	Total mass (kg)
Name	Num							
BOTTOM Y 1	01	12	7200.0	1	11	72000.0	70.32	
	02	12	6500.0	11	11	71500.0	63.49	
	03	12	6800.0	11	11	74800.0	66.42	
	04	12	7000.0	11	11	77000.0	68.38	
	05	12	4800.0	11	11	52800.0	46.86	
	06	12	6600.0	11	11	72600.0	64.47	
	07	12	9200.0	86	86	791200.0	702.59	
	10	12	12000.0	30	30	360000.0	319.69	
	11	12	7000.0	8	8	56000.0	49.73	
	12	12	8300.0	2	2	16600.0	14.74	
	13	12	4000.0	7	7	28000.0	24.86	
	14	12	3500.0	12	12	42000.0	37.30	
	20	12	7900.0	5	5	39500.0	35.08	
	21	12	5400.0	3	3	16200.0	14.39	
	22	12	8200.0	3	3	24600.0	21.84	
	23	12	12000.0	3	3	36000.0	31.97	
	24	12	3000.0	3	3	9000.0	7.99	
	25	12	8900.0	3	3	26700.0	23.71	
	26	12	9000.0	3	3	27000.0	23.98	
	27	12	9000.0	6	6	54000.0	47.95	
	28	12	6500.0	5	5	32500.0	28.89	
	31	12	6500.0	4	4	26000.0	23.09	
	32	12	2900.0	32	32	92800.0	82.41	
	33	12	6000.0	14	14	84000.0	74.59	
	34	12	6000.0	1	1	6000.0	5.33	
	35	12	9100.0	1	1	9100.0	8.08	
	36	12	6900.0	34	34	234600.0	208.32	
	37	12	7500.0	1	1	7500.0	6.66	
	38	12	10900.0	3	3	32700.0	29.04	
	39	12	4900.0	35	35	171500.0	152.20	
	40	12	6000.0	1	1	6000.0	5.33	
	41	12	8000.0	1	1	8000.0	7.10	
	42	12	3400.0	17	17	57800.0	51.33	
	43	12	2200.0	1	1	2200.0	1.95	
	44	12	3000.0	17	17	51000.0	45.39	
	45	12	2000.0	13	13	26000.0	23.09	
	46	12	6900.0	20	20	138000.0	122.54	
	47	12	5200.0	4	4	20800.0	18.47	
	48	12	4200.0	2	2	8400.0	7.46	
	49	12	6500.0	14	14	91000.0	80.81	
	50	12	3000.0	4	4	12000.0	10.66	
	51	12	2400.0	4	4	9600.0	8.52	
	52	12	6900.0 *	83	83	574360.0	510.03	
	54	12	5500.0	18	18	99000.0	87.91	
	55	12	5100.0	1	1	5100.0	4.56	
	56	12	6000.0	1	1	6000.0	5.33	
	57	12	8000.0	1	1	8000.0	7.10	
	58	12	6800.0	17	17	115600.0	102.65	
	59	12	6000.0	1	1	6000.0	5.33	
	60	12	9900.0	1	1	9900.0	8.79	
	61	12	6500.0	36	36	234000.0	207.79	
	62	12	7400.0	28	28	191200.0	170.85	
	63	12	4500.0	10	10	45000.0	39.98	
	64	12	7700.0	24	24	184800.0	164.10	
	65	12	6700.0	4	4	26800.0	23.80	
	66	12	5600.0	4	4	22400.0	19.89	
	67	12	9900.0 *	14	14	83300.0	73.97	
	68	12	1900.0	8	8	15200.0	13.50	
	69	12	2100.0	1	1	2100.0	1.86	
	70	12	2800.0	4	4	11200.0	9.95	
	71	12	7000.0	2	2	14000.0	12.43	
	72	12	5500.0	4	4	22000.0	19.54	
	73	12	7000.0	4	4	28000.0	24.86	
	74	12	9500.0	2	2	19000.0	16.87	
	75	12	8400.0	11	11	92400.0	82.05	
	76	12	4600.0	4	4	18400.0	16.34	
	77	12	2600.0	1	1	2600.0	2.31	
	78	12	3000.0	2	2	6000.0	5.33	
	79	12	2300.0	9	9	20700.0	18.38	
	80	12	2700.0	2	2	5400.0	4.80	
	81	12	4500.0	8	8	36000.0	31.97	
	82	12	1200.0	2	2	2400.0	2.13	
	83	12	4000.0	9	9	36000.0	31.97	
	84	12	5500.0	9	9	49500.0	43.86	
	85	12	7900.0	10	10	79000.0	70.15	
	86	12	6000.0	3	3	18000.0	15.98	
	87	12	6300.0	2	2	12600.0	11.19	
	88	12	5800.0	2	2	11600.0	10.30	
	89	12	2300.0	7	7	16100.0	14.30	
	90	12	2500.0	3	3	7500.0	6.66	
	91	12	9400.0	8	8	75200.0	65.47	
	92	12	7400.0	6	6	44400.0	39.43	
	93	12	6900.0	18	18	124200.0	110.29	
	94	12	6800.0	18	18	122400.0	108.69	
	95	12	4900.0	18	18	88200.0	78.32	
	96	12	4800.0	15	15	72000.0	63.77	
	97	12	5500.0	92	92	506000.0	449.33	
	98	12	6500.0	23	23	149500.0	132.76	
	99	12	7100.0	7	7	49700.0	44.13	
	100	12	6700.0	23	23	154100.0	136.84	
	101	12	6000.0	98	98	588000.0	522.14	
	102	12	6500.0	28	28	182000.0	161.62	
	103	12	8300.0	7	7	58100.0	51.59	
	104	12	8000.0	2	2	16000.0	14.31	
	105	12	9800.0	10	10	98000.0	87.02	
	106	12	9200.0	3	3	27600.0	24.51	
	107	12	8300.0	8	8	66400.0	58.96	
	108	12	6500.0	69	69	448500.0	398.27	
	109	12	7400.0	8	8	59200.0	52.57	
	110	12	8300.0	7	7	58100.0	51.59	
	111	12	10900.0	21	21	228900.0	203.26	
	112	12	7400.0	1	1	7400.0	6.57	
	113	12	6400.0	14	14	89600.0	79.56	
	114	12	8200.0	3	3	24600.0	21.84	
	115	12	8300.0	3	3	24900.0	22.11	
	116	12	8000.0	42	42	336000.0	305.66	
	117	12	7200.0	1	1	7200.0	6.39	
	118	12	6000.0	13	13	78000.0	69.26	
	119	12	12000.0	26	26	312000.0	277.06	
	120	12	6000.0	26	26	156000.0	138.53	
	121	12	12000.0	26	26	312000.0	277.06	
	122	12	7700.0	12	12	92400.0	82.05	
	123	12	6700.0	12	12	80400.0	71.40	
	124	12	7000.0	13	13	91000.0	80.91	
	125	12	5200.0	1	1	5200.0	4.62	
	126	12	4200.0	1	1	4200.0	3.73	
	127	12	5000.0	8	8	40000.0	35.52	
	128	12	1200.0	8	8	9600.0	85.25	
	130	12	3200.0	7	7	22400.0	19.89	
	131	12	7000.0	1	1	7000.0	6.22	
	132	12	6200.0	1	1	6200.0	5.51	
	133	12	9000.0	10	10	90000.0	79.93	
	134	12	9700.0	5	5	48500.0	43.07	
	135	12	8000.0	5	5	40000.0	35.52	
	136	12	6000.0	5	5	30000.0	26.64	
	137	12	8700.0	5	5	43500.0	38.43	
	138	12	12000.0	1	1	12000.0	10.66	
	139	12	6600.0	7	7	46200.0	41.03	
	140	12	9300.0	12	12	111600.0	99.10	
	141	12	10500.0	11	11	115500.0	102.59	
	142	12	6300.0			6300.0	5.59	
	143	12	6600.0	3	3	19800.0	17.58	
	144	12	8000.0	4	4	32000.0	28.42	
	145	12	6200.0	1	1	6200.0	5.51	
	146	12	12000.0	11	11	132000.0	117.22	
	147	12	12000.0	10	10	120000.0	106.58	
	148	12	6000.0	27	27	162000.0	143.86	
	149	12	6000.0	11	11	66000.0	58.61	
	150	12	6000.0	30	30	180000.0	159.84	
	151	12	9100.0	4	4	36400.0	32.32	
	152	12	9800.0	3	3	29400.0	26.11	
	153	12	5500.0	4	4	22000.0	19.54	
	154	12	12000.0	8	8	96000.0	85.25	
	155	12	7500.0	1	1	7500.0	6.66	

Elements		POS.	DIA.	Length (mm)	Number		Total Length (mm)	Mass (kg)	Total mass (kg)
Name	Num				In the element	total			
Average length	155	12	7500.0	1	1	7500.0	6.66		
	156	12	12000.0	10	10	120000.0	106.58		
	157	12	6000.0	10	10	60000.0	53.28		
	158	12	12000.0	10	10	120000.0	106.58		
	159	12	12000.0	42	42	504000.0	447.55		
	160	12	4300.0	10	10	43000.0	38.94		
	161	12	2900.0	1	1	2900.0	2.58		
	162	12	9300.0	1	1	9300.0	8.26		
	163	12	12000.0	20	20	240000.0	213.12		
	164	12	6000.0	19	19	114000.0	101.23		
	165	12	8800.0	17	17	149600.0	132.84		
	166	12	9000.0	19	19	171000.0	151.85		
	167	12	12000.0	12	12	144000.0	127.87		
	168	12	6500.0	17	17	110500.0	98.12		
	169	12	3000.0	5	5	15000.0	13.48		
	170	12	10000.0	6	6	84000.0	75.30		
	171	12	1000.0	6	6	6000.0	5.33		
	172	12	8600.0	6	6	88800.0	81.09		
	173	12	12000.0	10	10	120000.0	106.58		
	174	12	12000.0	19	19	228000.0	202.48		
	175	12	6400.0	6	6	36400.0	34.10		
	176	12	3000.0	6	6	18000.0	15.98		
	177	12	4000.0	5	5	20000.0	17.76		
	178	12	4500.0	5	5	22500.0	20.15		
179	12	5000.0	1	1	5000.0	4.44			
180	12	12000.0	18	18	216000.0	191.87			
181	12	2400.0	7	7	16800.0	14.92			
182	12	8400.0	6	6	50400.0	44.76			
183	12	6000.0	6	6	36000.0	31.97			
184	12	12000.0	42	42	504000.0	447.55			
185	12	7000.0	11	11	77000.0	68.38			
186	12	6000.0	10	10	60000.0	53.28			
187	12	6000.0	10	10	60000.0	53.28			
188	12	6000.0	10	10	60000.0	53.28			
189	12	7700.0	10	10	77000.0	68.38			
190	12	10000.0	72	72	720000.0	639.36			
191	12	4800.0	10	10	48000.0	42.44			
193	12	8000.0	36	36	288000.0	255.74			
194	12	8800.0	36	36	316800.0	281.32			
195	12	4000.0	38	38	154000.0	127.87			
196	12	6700.0	10	10	67000.0	59.73			
197	12	6400.0	4	4	25600.0	23.04			
224	12	3350.0	* 40	40	134000.0	118.89			
225	12	3500.0	15	15	52500.0	46.60			
226	12	7300.0	10	10	73000.0	64.74			
230	18	6400.0	4	4	25600.0	21.20			
234	12	2100.0	2	2	4200.0	3.73			

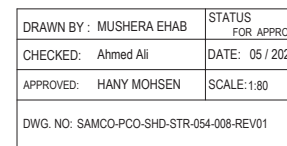


DETAIL (A)

Elements	POS.	DIA.	Length (mm)	Number	Total	Mass	Total mass
Name	Num			In the element	Length (mm)	(kg)	(kg)
TOP Y 1	01	12	12000.0	21	21	252000.0	223.78
	02	12	9000.0	39	39	351000.0	311.68
	03	12	10500.0	21	21	220500.0	195.85
	04	12	9000.0	39	39	351000.0	311.68
	05	12	6000.0	39	39	234000.0	207.78
	06	12	6000.0	39	39	234000.0	207.78
	07	12	3000.0	39	39	117000.0	103.94
	08	12	10500.0	21	21	220500.0	195.85
	11	12	12000.0	39	39	468000.0	415.58
	12	12	6000.0	39	39	234000.0	207.78
	13	12	12000.0	39	39	468000.0	415.58
	14	12	9000.0	21	21	189000.0	167.83
	15	12	5000.0	94	94	470000.0	417.36
	16	12	7000.0	43	43	301000.0	267.29
	17	12	12000.0	43	43	516000.0	458.21
	18	12	9000.0	42	42	378000.0	335.66
	20	12	12000.0	39	39	468000.0	415.58
	21	12	9000.0	42	42	378000.0	335.66
	22	12	7000.0	42	42	294000.0	261.03
	23	12	10500.0	42	42	441000.0	391.61
	24	12	6000.0	37	37	222000.0	197.14
	25	12	8300.0	42	42	348600.0	309.56
	26	12	8400.0	7	7	58800.0	52.21
	27	12	3300.0	4	4	13200.0	11.72
	28	12	4800.0	3	3	14400.0	12.79
	29	12	5600.0	3	3	16800.0	14.92
	30	12	8600.0	3	3	25800.0	23.01
TOP Y 1	31	12	1200.0	3	3	3600.0	3.20
	32	12	3000.0	3	3	9000.0	7.99
	33	12	6000.0	3	3	18000.0	15.98
	34	12	8000.0	3	3	24000.0	21.31
	35	12	7000.0	2	2	14000.0	12.43
	36	12	6700.0	13	13	87100.0	77.34
	37	12	7700.0	12	12	92400.0	82.05
	38	12	8000.0	1	1	8000.0	7.10
	39	12	7400.0	16	16	118400.0	105.14
	40	12	4500.0	10	10	45000.0	39.96
	41	12	3700.0	1	1	3700.0	3.29
	42	12	8000.0	1	1	8000.0	7.10
	43	12	2000.0	10	10	20000.0	17.76
	64	12	7700.0	24	24	184800.0	164.10
	65	12	6700.0	4	4	26800.0	23.80
	66	12	5600.0	4	4	22400.0	19.89
	67	12	6300.0	14	14	88200.0	78.32
	69	12	1900.0	14	14	26600.0	23.62
	70	12	2800.0	2	2	5600.0	4.97
	71	12	7000.0	2	2	14000.0	12.43
	74	12	9500.0	2	2	19000.0	16.87
	75	12	6000.0	2	2	12000.0	10.66
	76	12	5400.0	3	3	16200.0	14.39
	77	12	11500.0	3	3	34500.0	30.64
	78	12	8600.0	2	2	17200.0	15.27
	79	12	8300.0	13	13	107900.0	95.82
	80	12	8900.0	12	12	106800.0	94.84
	81	12	9200.0	2	2	18400.0	16.34
	82	12	5400.0	4	4	21600.0	19.18
	83	12	3900.0	3	3	11700.0	10.39
	84	12	6000.0	23	23	138000.0	122.54
	85	12	6200.0	23	23	142600.0	126.83
	86	12	5600.0	95	95	532000.0	472.42
	87	12	9400.0	13	13	122200.0	108.51
	88	12	9600.0	25	25	240000.0	213.12
	89	12	10200.0	23	23	234600.0	208.35
	90	12	9600.0	170	170	1632000.0	1449.22
	91	12	11400.0	21	21	239400.0	212.58
	92	12	12000.0	18	18	216000.0	191.81
	93	12	10500.0	18	18	189000.0	167.83
	94	12	10500.0	18	18	189000.0	167.83
	95	12	9000.0	18	18	162000.0	143.86
	96	12	12000.0	6	6	72000.0	63.94
	97	12	2300.0	6	6	13800.0	11.72
	98	12	12000.0	10	10	120000.0	106.58
	99	12	2200.0	6	6	13200.0	11.72
	100	12	7000.0	11	11	77000.0	68.38
	101	12	6000.0	10	10	60000.0	53.28
	102	12	9000.0	11	11	99000.0	87.91
	103	12	12000.0	40	40	480000.0	426.24
	104	12	9000.0	11	11	99000.0	87.91
	105	12	10500.0	10	10	105000.0	93.24
	106	12	12000.0	18	18	216000.0	191.81
	107	12	8500.0	10	10	85000.0	75.48
	108	12	7000.0	36	36	252000.0	223.78
	109	12	12000.0	17	17	204000.0	181.15
	110	12	8700.0	36	36	313200.0	278.12
	111	12	9000.0	36	36	324000.0	287.71
	112	12	9000.0	36	36	324000.0	287.71
	113	12	6400.0	28	28	179200.0	159.13
	114	12	9600.0	36	36	345600.0	306.88
	115	12	6400.0	17	17	108800.0	96.61
	116	12	2400.0	4	4	9600.0	8.52
	117	12	5600.0	3	3	16800.0	14.92
	118	12	6000.0	3	3	18000.0	15.98
	119	12	3600.0	4	4	14400.0	12.79
	190	12	10000.0	72	72	720000.0	639.36
	224	12	2000.0	10	10	20000.0	17.76
	226	12	5400.0	2	2	10800.0	9.59
	227	12	4400.0	2	2	8800.0	7.81
	228	12	7400.0	18	18	133200.0	118.28
	229	12	4500.0	10	10	45000.0	39.96
	230	12	1900.0	4	4	7600.0	6.75
	231	12	5500.0	4	4	22000.0	19.54
	232	12	7400.0	2	2	14800.0	13.14
	233	12	7400.0	2	2	14800.0	13.14
	234	12	7000.0	20	20	140000.0	124.32
	235	12	5400.0	2	2	10800.0	9.59
	236	12	6400.0	19	19	121600.0	107.98
	237	12	12000.0	19	19	228000.0	202.46
	238	12	9000.0	25	25	225000.0	199.85
	239	12	5000.0	4	4	20000.0	17.76
	240	12	2600.0	4	4	10400.0	9.24
	241	12	3480.0	3	3	10440.0	9.27
	242	12	5800.0	4	4	23200.0	20.60
	243	12	2400.0	4	4	9600.0	8.52
	244	12	5600.0	3	3	16800.0	14.92
	245	12	7000.0	8	8	56000.0	49.73
	246	12	12000.0	8	8	96000.0	85.25
	247	12	10500.0	8	8	84000.0	74.59
	248	12	6400.0	8	8	51200.0	45.47
	249	12	6400.0	8	8	51200.0	45.47
	250	12	8400.0	8	8	67200.0	59.67
	251	12	12000.0	72	72	864000.0	767.21
	252	12	8600.0	2	2	17200.0	15.27
	253	12	8200.0	4	4	32800.0	29.13
	254	12	2100.0	1	1	2100.0	1.86
	255	18	6500.0	4	4	26000.0	52.00

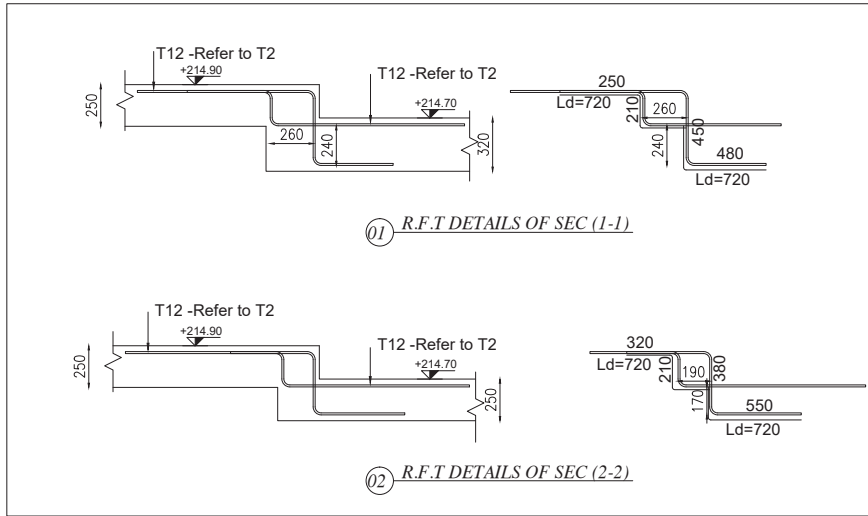

BBS are out of approval

Finally BBS quantities are subject to final approval for as built take-off

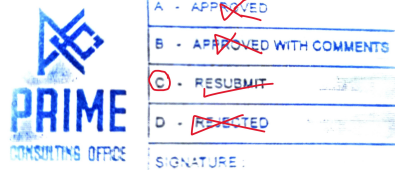

Code / C

GENERAL NOTES				
C. CONCRETE				
C.1. CHARACTERISTIC CONCRETE COMPRESSIVE STRENGTH AT 28 DAYS SHALL BE AS FOLLOWS:				
CONCRETE	28 DAYS CURE STRENGTH	MINIMUM CEMENT CONTENT	CEMENT TYPE	MAXIMUM W/C
PLAIN CONCRETE / SLABING	20	250	OPC	0.50
SLAB ON GRADE	25	300	OPC	0.45
FOUNDATION/RETAINING WALLS	25	400	OPC	0.45
SUPER STRUCTURE	25	350	OPC	0.45
C.2. MAXIMUM AGGREGATE SIZE SHALL NOT EXCEED 20 mm.				
C.3. NOMINAL COVER TO ALL REINFORCEMENT (INCLUDING LINKS) SHALL BE AS FOLLOWS UNL:				
STRUCTURAL ELEMENT	mm			
FOUNDATION	50 FOR ALL FACES			
SHEAR WALLS	30 FOR ALL FACES			
RETAINING WALLS	35 AIR SIDE 20 EXTER SIDE			
COLUMNS	30 FOR ALL FACES			
BEAMS	30 FOR ALL FACES			
SLABS	20 FOR ALL FACES			
C.4. PARAPETS AND LINTELS SHALL BE CAST AFTER STRIKING FORM WORK OF SLABS AND BEAMS. CONTRACTOR TO PROVIDE DOBBLES FROM SLABS, BEAMS AND COLUMNS FOR PARAPETS AND LINTEL REINFORCEMENT.				
C.5. ALL FRESHLY PLACED CONCRETE SURFACES SHALL BE PROPERLY CURED, KEPT MOIST AND PROTECTED FROM DIRECT SUNLIGHT.				
C.6. ALL CONSTRUCTION JOINTS OF REINFORCED CONCRETE MEMBERS SHALL BE REINFORCED OR SHALL HAVE SHEAR KEYS. IMMEDIATELY BEFORE NEW CONCRETE IS PLACED ALL CONSTRUCTION JOINTS SHALL BE WETTED AND SPREADING WATER REMOVED.				
C.7. ALL CONSTRUCTION JOINTS IN FLOORS SHALL BE LOCATED WITHIN THE MIDDLE THIRD OF SPANS OF SLABS, BEAMS, AND GIRDERS. CONSTRUCTION JOINTS IN GIRDERS SHALL BE OFFSET BY A MINIMUM DISTANCE OF TWO TIMES THE WIDTH OF INTERSECTING BEAMS.				
C.8. WHERE CONCRETE BEAMS ARE CAST IN TWO PHASES, THE SURFACE OF PHASE 1 SHALL BE REINFORCED TO FULL AMPLITUDE OF 8 mm. THE SURFACE SHALL BE CLEAN, FREE FROM DUST AND LATTICE, AND WET.				
C.9. LOCATION OF CONSTRUCTION JOINT SHALL BE SUBJECT TO THE ENGINEER'S APPROVAL.				
C.10. ALL CONCRETE SHALL BE COMPACTED USING A MECHANICAL VIBRATORS.				
C.11. HEAVY CONSTRUCTION EQUIPMENT AND TRUCKS ARE NOT ALLOWED TO PASS OVER THE GROUND FLOOR SLAB. CONTRACTOR SHALL TAKE ALL THE NECESSARY PRECAUTIONS TO AVOID DAMAGE TO A SLAB.				
C.12. WHEN CASTING A LARGE AREA OR A LARGE VOLUME OF CONCRETE, CONTRACTOR SHALL TAKE ALL THE NECESSARY PRECAUTIONS TO AVOID SHRINKAGE AND THERMAL CRACKS. SUCH AS, BUT NOT LIMITED TO, CONSTRUCTION JOINTS, SPRINKLING WATER, THE COLORING OF CEMENT, USE OF ICE IN MIXING WATER, SHADING OF THE CAST CONCRETE AREA AND CURING.				
C.13. MINIMUM PERIOD BEFORE STRIKING FORM WORK SHALL BE IN ACCORDANCE WITH EOP/BS.				

01	05-2026	FOR CONSULTANT APPROVAL
00	03-2026	FOR CONSULTANT APPROVAL
REV	DATE	DESCRIPTION

KEY PLAN

THE BIG BUSINESS DISTRICT
New Cairo ,Cairo

CLIENT:

ROYA DEVELOPMENTS

Consultant:

ACE-PM
MOHARRAM BAKHOUM

Consultant:

PRIME CONSULTING OFFICE

Contractor:


SAMCO National Construction Co.
شركة سامكو الوطنية للبناء

DESIGN DRAWINGS REFS :	
APPROVAL DATED 30-04-2026	30-04-2026 -IFC Package (B01,B02,B03&B04) S0001-GENERAL NOTES

Drawing title

BBS OF R.F.T DETAILS TOP(Y-DIRECTION) OF GROUND PART 2 (B1&B2) SHEET (9/15)

DRAWN BY : MUSERA EAHAB	STATUS FOR APPROVAL
CHECKED: Ahmed Ali	DATE: 05 / 2026
APPROVED: HANY MOHSEN	SCALE: 1:80
DWG. NO: SAMCO-PCO-SHD-STR-054-009-REV01	

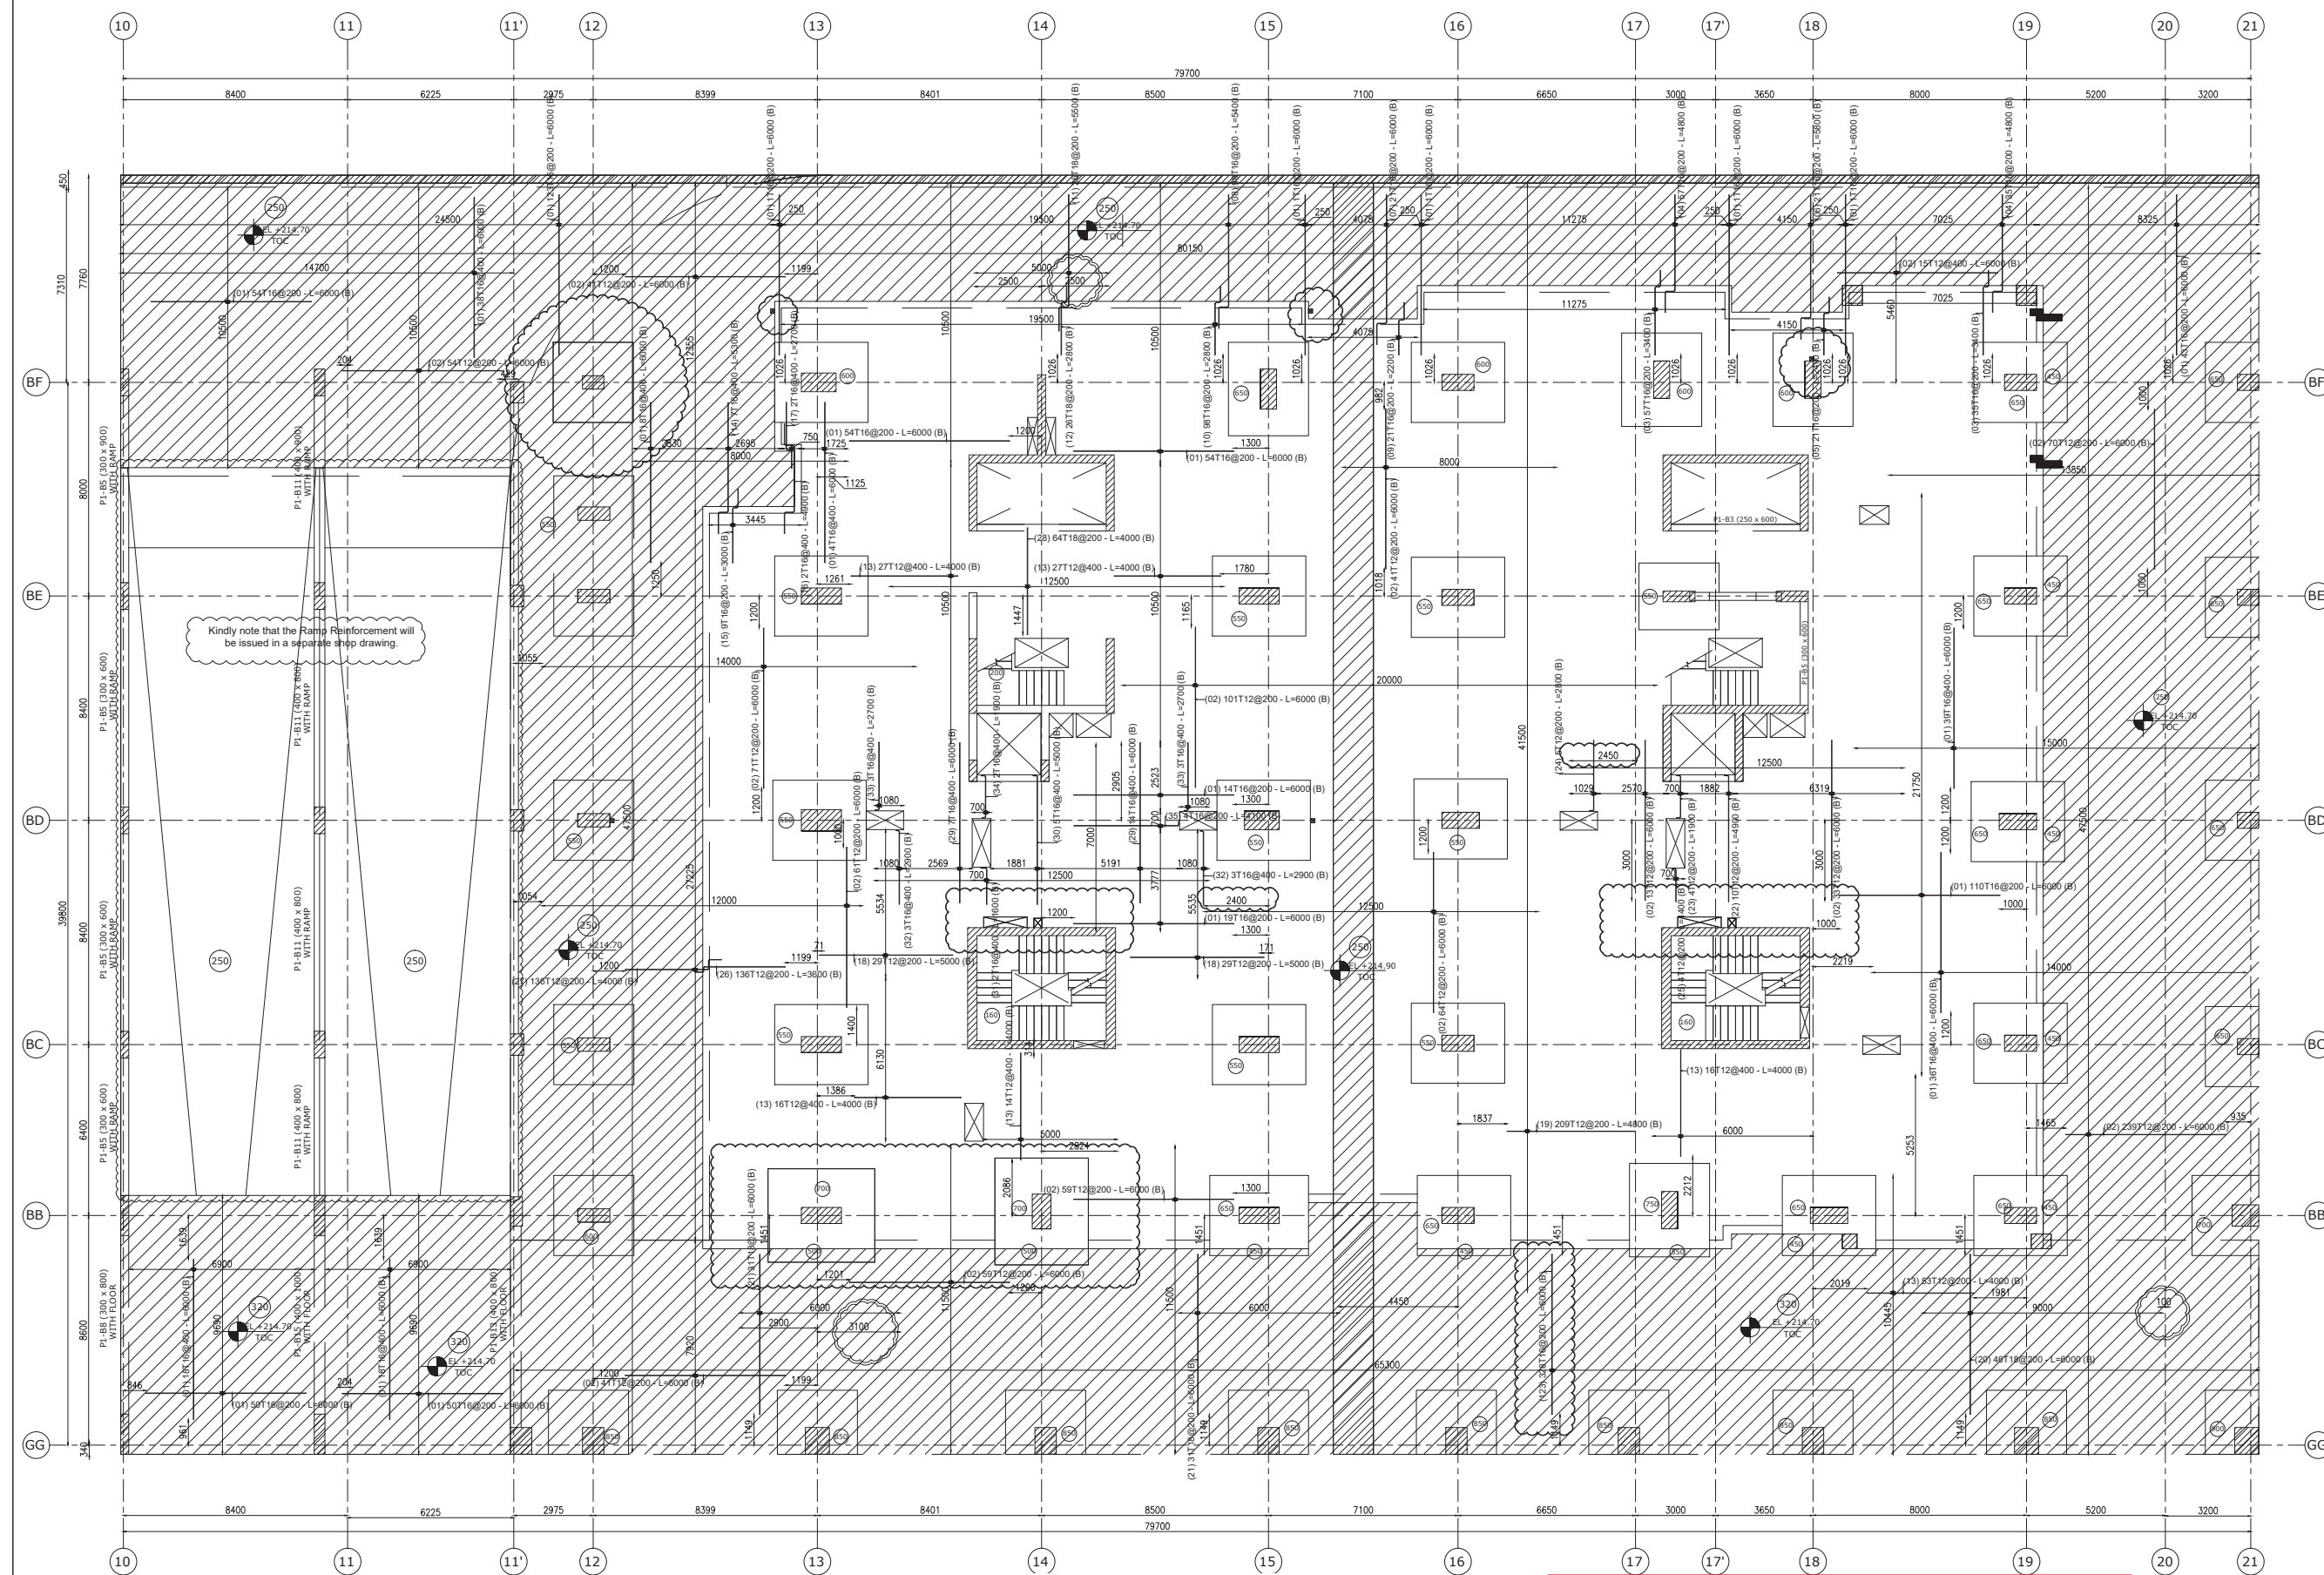

GENERAL NOTES

C. CONCRETE

C.1. CHARACTERISTIC CONCRETE COMPRESSIVE STRENGTH AT 28 DAYS SHALL BE AS FOLLOWS:

CONCRETE	28 DAYS CURE STRENGTH (MPa)	MINIMUM CEMENT TYPE	MINIMUM W/C
PLAIN CONCRETE (SLABING)	25	OPC	0.50
SLAB ON GRADE	25	OPC	0.45
FOUNDATION/RETAINING WALLS	25	OPC	0.45
RAFTER STRUCTURE	25	OPC	0.45

C.2. MAXIMUM AGGREGATE SIZE SHALL NOT EXCEED 20 mm.

C.3. NOMINAL COVER TO ALL REINFORCEMENT (INCLUDING LINKS) SHALL BE AS FOLLOWS UNO:

STRUCTURAL ELEMENT	mm
FOUNDATION	50 FOR ALL FACES
BEAM WALLS	30 FOR ALL FACES
RETAINING WALLS	30 EXPOSED SIDE 35 AIR SIDE
COLUMNS	30 FOR ALL FACES
BEAMS	30 FOR ALL FACES
SLABS	20 FOR ALL FACES

C.4. PARAPETS AND LINTELS SHALL BE CAST AFTER STRIKING FORM WORK OF SLABS AND BEAMS. CONTRACTOR TO PROVIDE DOWELS FROM SLABS, BEAMS AND COLUMNS FOR PARAPETS AND LINTELS REINFORCEMENT.

C.5. ALL FRESHLY PLACED CONCRETE SURFACES SHALL BE PROPERLY CURED, KEPT MOIST AND PROTECTED FROM DIRECT SUNLIGHT.

C.6. ALL CONSTRUCTION JOINTS OF REINFORCED CONCRETE MEMBERS SHALL BE REINFORCED OR SHALL HAVE REINFORCED IMMEDIATELY BEFORE NEW CONCRETE IS PLACED. ALL CONSTRUCTION JOINTS SHALL BE KEPT CLEAN AND FREE FROM WATER REMOVED.

C.7. ALL CONSTRUCTION JOINTS IN FLOORS SHALL BE LOCATED WITHIN THE MIDDLE THIRD OF SPANS OF SLABS, BEAMS, AND GIRDERS. CONSTRUCTION JOINTS IN GIRDERS SHALL BE KEPT AT A MINIMUM DISTANCE OF TWO TIMES THE WIDTH OF INTERSECTING BEAMS.

C.8. WHERE CONCRETE BEAMS ARE CAST IN TWO PHASES, THE SURFACE OF PHASE 1 SHALL BE REINFORCED TO FULL AMPLITUDE OF 10 mm. THE SURFACE SHALL BE KEPT FREE FROM DUST AND LATTICE, AND NOT.

C.9. LOCATION OF CONSTRUCTION JOINT SHALL BE SUBJECT TO THE ENGINEER'S APPROVAL.

C.10. ALL CONCRETE SHALL BE COMPACTED USING A MECHANICAL VIBRATOR.

C.11. WHEN CONSTRUCTION EQUIPMENT AND TRUCKS ARE NOT ALLOWED TO PASS OVER THE GROUND FLOOR SLAB, CONTRACTOR SHALL TAKE ALL THE NECESSARY PRECAUTIONS TO AVOID DAMAGE TO A SLAB.

C.12. WHEN CASTING A LARGE AREA OF CONCRETE, CONTRACTOR SHALL TAKE ALL THE NECESSARY PRECAUTIONS TO AVOID OVERHEATING AND THERMAL CRACKS. SUCH AS, AND NOT LIMITED TO, CONSTRUCTION JOINTS, INTERNAL STIFFENERS, SUCH AS, AND NOT LIMITED TO, CONSTRUCTION JOINTS, SHADING OF THE CAST CONCRETE AREA AND CURING.

C.13. MINIMUM PERIOD BEFORE STRIKING FORM SHALL BE IN ACCORDANCE WITH EOP/BS.

REV	DATE	DESCRIPTION
01	04-2026	FOR CONSULTANT APPROVAL
00	03-2026	FOR CONSULTANT APPROVAL

KEY PLAN

THE BIG BUSINESS DISTRICT
New Cairo, Cairo

CLIENT:

ROYA DEVELOPMENTS

Consultant:

ACE-PM
MOHARRAM BAKHOUM

Consultant:

PRIME
CONSULTING OFFICE

Contractor:

SAMCO
SAMCO National Construction Co.
شركة سامكو الوطنية للبناء

DESIGN DRAWINGS REFS :

APPROVAL DATED 30-04-2026

30-04-2026-IFC Package
(B01,B02,B03&B04)
S0001-GENERAL NOTES

Drawing title

R.F.T DETAILS OF BOTTOM ADD OF GROUND PART 2 (B1&B2) SHEET (10/15)

DRAWN BY : MUSERA E HAB STATUS FOR APPROVAL

CHECKED: Ahmed Ali DATE: 04 / 2026

APPROVED: HANY MOHSEN SCALE:1:80

DWG. NO: SAMCO-PCO-SHD-STR-054-010-REV01

PRIME
CONSULTING OFFICE

APPROVED

B - APPROVED WITH COMMENTS

RESUBMIT


REJECTED

SIGNATURE

- Any modifications in concrete dimensions approved shop drawings should be reflected in these drawings.

- Only coluded areas are reviewed and approved in this drawing

Code / B

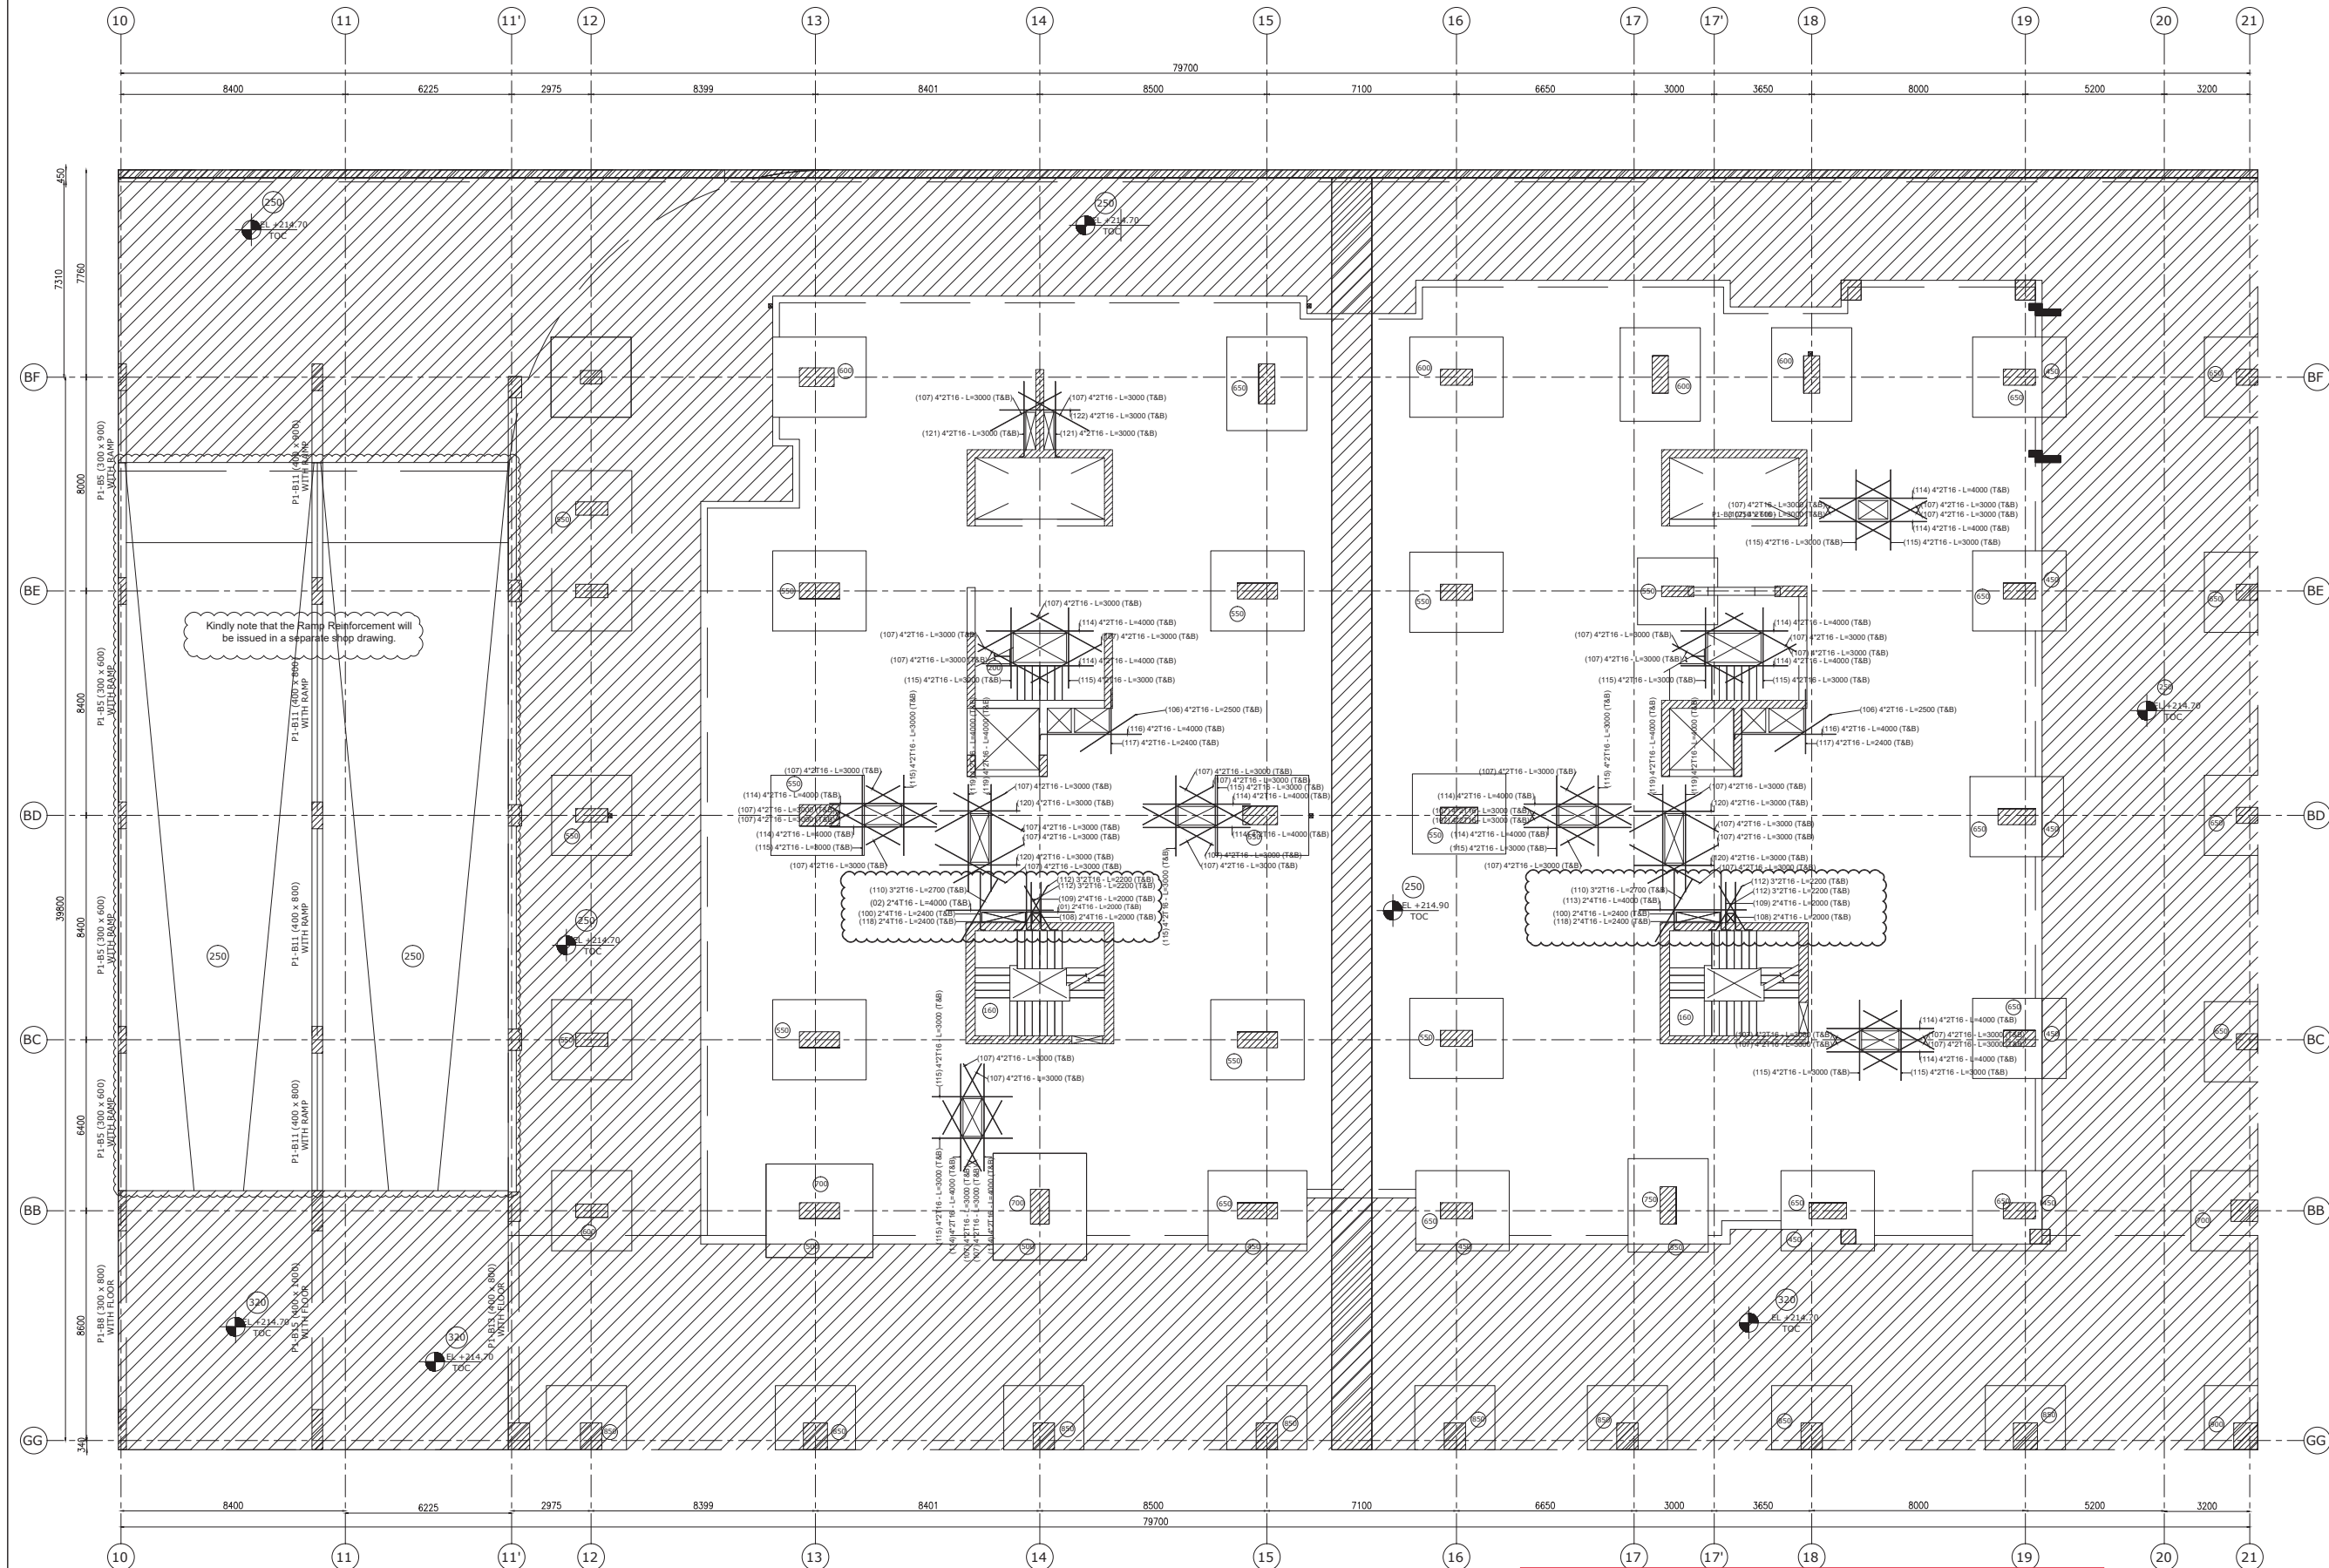

GENERAL NOTES

C. CONCRETE

C.1. CHARACTERISTIC CONCRETE COMPRESSIVE STRENGTH AT 28 DAYS SHALL BE AS FOLLOWS:

CONCRETE	28 DAYS CURE STRENGTH CONCRETE	MINIMUM STRENGTH	MINIMUM STRENGTH	MINIMUM STRENGTH
PLAIN CONCRETE (SLABING)	25	20	20	20
SLAB ON GRADE	25	20	20	20
FOUNDATION/RETAINING WALLS	25	20	20	20
RAFTER STRUCTURE	25	20	20	20

C.2. MAXIMUM AGGREGATE SIZE SHALL NOT EXCEED 20 mm.

C.3. NOMINAL COVER TO ALL REINFORCEMENT (INCLUDING LINKS) SHALL BE AS FOLLOWS UNLESS SPECIFIED OTHERWISE:

STRUCTURAL ELEMENT	MIN. COVER
FOUNDATION	50 FOR ALL FACES
BEAM WALLS	30 FOR ALL FACES
RETAINING WALLS	30 FOR ALL FACES
COLUMNS	30 FOR ALL FACES
SLABS	20 FOR ALL FACES

C.4. PARAPETS AND LINTELS SHALL BE CAST AFTER STRIKING FORM WORK OF SLABS AND BEAMS. CONTRACTOR TO PROVIDE DOWELS FROM SLABS, BEAMS AND COLUMNS FOR PARAPETS AND LINTEL REINFORCEMENT.

C.5. ALL FRESHLY POURED CONCRETE SURFACES SHALL BE PROPERLY CURED, KEPT MOIST AND PROTECTED FROM DIRECT SUNLIGHT.

C.6. ALL CONSTRUCTION JOINTS OF REINFORCED CONCRETE MEMBERS SHALL BE REINFORCED OR SHALL HAVE SHEAR KEYS. IMMEDIATELY BEFORE NEW CONCRETE IS PLACED ALL CONSTRUCTION JOINTS SHALL BE WETTED AND STANDING WATER REMOVED.

C.7. ALL CONSTRUCTION JOINTS IN FLOORS SHALL BE LOCATED WITHIN THE MIDDLE THIRD OF SPANS OF SLABS, BEAMS, AND GIRDERS. CONSTRUCTION JOINTS IN GIRDERS SHALL BE OFFSET A MINIMUM DISTANCE OF TWO TIMES THE WIDTH OF INTERSECTING BEAMS.

C.8. WHERE CONCRETE BEAMS ARE CAST IN TWO PHASES, THE SURFACE OF PHASE 1 SHALL BE REINFORCED TO FULL AMPLITUDE OF 10 mm. THE SURFACE SHALL BE KEPT FREE FROM DUST AND LINTES, AND SET.

C.9. LOCATION OF CONSTRUCTION JOINT SHALL BE SUBJECT TO THE ENGINEER'S APPROVAL.

C.10. ALL CONCRETE SHALL BE COMPACTED USING A MECHANICAL VIBRATOR.


C.11. HEAVY CONSTRUCTION EQUIPMENT AND TRUCKS ARE NOT ALLOWED TO PASS OVER THE GROUND FLOOR SLAB. CONTRACTOR SHALL TAKE ALL THE NECESSARY PRECAUTIONS TO AVOID DAMAGE TO A SLAB.

C.12. WHEN CASTING A LARGE AREA OR A LARGE VOLUME OF CONCRETE, CONTRACTOR SHALL TAKE ALL THE NECESSARY PRECAUTIONS TO AVOID SHRINKAGE AND THERMAL STRESS. SUCH AS, BUT NOT LIMITED TO, CONSTRUCTION JOINTS, SHRINKAGE JOINTS, PRECASTING OF CONCRETE, USE OF ICE IN MIXING WATER, SHADING OF THE CAST CONCRETE AREA AND CURING.

C.13. MINIMUM PERIOD BEFORE STRIKING FORM WORK SHALL BE IN ACCORDANCE WITH ECP 203.

REV	DATE	DESCRIPTION
01	04-2026	FOR CONSULTANT APPROVAL
00	03-2026	FOR CONSULTANT APPROVAL

KEY PLAN

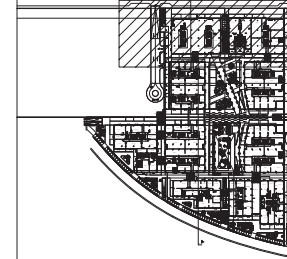

THE BIG BUSINESS DISTRICT
New Cairo, Cairo



DESIGN DRAWINGS REFS :

APPROVAL DATED	30-04-2026 - IFC Package (B01,B02,B03&B04)
30001-GENERAL NOTES	

Drawing title

R.F.T DETAILS OF OPENING OF GROUND PART 2 (B1&B2) SHEET (11/15)

DRAWN BY :	MUSHERA E HAB	STATUS	FOR APPROVAL
CHECKED :	Ahmed Ali	DATE :	04 / 2026
APPROVED :	HANY MOHSEN	SCALE :	1:80
DWG. NO: SAMCO-PCO-SHD-STR-054-011-REV01			



APPROVED	APPROVED WITH COMMENTS	RESUBMIT	REJECTED

SIGNATURE

- Any modifications in concrete dimensions approved shop drawings should be reflected in these drawings.

- Only coluded areas are reviewed and approved in this drawing

Code / B


Elements		POS.	DIA.	Length (mm)	Number		Total Length (mm)	Mass (kg)	Total mass (kg)
Name	Num				In the element	total			
ADD BOTTOM	1	01	16	6000.0	737	737	4422000.0	8986.76	27592.61
		02	16	6000.0	962	962	5772000.0	1119.76	
		03	16	3400.0	92	92	312800.0	494.22	
		04	16	4800.0	92	92	441600.0	697.73	
		05	16	2400.0	21	21	50400.0	79.63	
		06	16	5800.0	21	21	121800.0	192.44	
		07	16	6000.0	21	21	126000.0	199.08	
		08	16	5400.0	98	98	529200.0	836.14	
		09	16	2200.0	21	21	46200.0	73.00	
		10	16	2800.0	98	98	274400.0	433.55	
		11	18	5500.0	26	26	143000.0	286.00	
		12	18	2800.0	26	26	72800.0	145.60	
		13	12	4000.0	153	153	612000.0	543.46	
		14	16	5300.0	7	7	37100.0	58.62	
		15	16	3000.0	9	9	27000.0	42.66	
		16	16	4900.0	2	2	9800.0	15.48	
		17	16	2700.0	2	2	5400.0	8.53	
		18	12	5000.0	58	58	290000.0	257.52	
		19	12	4800.0	209	209	1003200.0	890.84	
		20	18	6000.0	46	46	276000.0	552.00	
		21	18	6000.0	62	62	372000.0	744.00	
		22	12	4900.0	10	10	49000.0	43.51	
		23	12	1900.0	4	4	7600.0	6.75	
		24	12	2800.0	5	5	14000.0	12.43	
		25	12	1400.0	4	4	5600.0	4.97	
		26	12	3600.0	136	136	489600.0	434.76	
		27	12	4000.0	136	136	544000.0	483.07	
		28	18	4000.0	64	64	256000.0	512.00	
		29	16	6000.0	21	21	126000.0	199.08	
		30	16	5000.0	5	5	25000.0	39.50	
		31	16	1600.0	2	2	3200.0	5.06	
		32	16	2900.0	6	6	17400.0	27.49	
		33	16	2700.0	6	6	16200.0	25.60	
		34	16	1900.0	2	2	3800.0	6.00	
		35	16	4100.0	4	4	16400.0	25.91	
		123	16	6000.0	328	328	1968000.0	109.44	

Elements		POS.	DIA.	Length (mm)	Number		Total Length (mm)	Mass (kg)	Total mass (kg)
Name	Num				In the element	total			
R.F.T OPENING	1	01	16	2000.0	8	8	16000.0	25.28	4184.47
		02	16	4000.0	8	8	32000.0	50.56	
		100	16	2400.0	16	16	38400.0	60.67	
		106	16	2500.0	16	16	40000.0	63.20	
		107	16	3000.0	336	336	1008000.0	1592.64	
		108	16	2000.0	16	16	32000.0	50.56	
		109	16	2000.0	16	16	32000.0	50.56	
		110	16	2700.0	12	12	32400.0	51.19	
		112	16	2200.0	24	24	52800.0	83.42	
		113	16	4000.0	8	8	32000.0	50.56	
		114	16	4000.0	128	128	512000.0	808.96	
		115	16	3000.0	128	128	384000.0	606.72	
		116	16	4000.0	16	16	64000.0	101.12	
		117	16	2400.0	16	16	38400.0	60.67	
		118	16	2400.0	16	16	38400.0	60.67	
		119	16	4000.0	32	32	128000.0	202.24	
		120	16	3000.0	32	32	96000.0	151.68	
		121	16	3000.0	16	16	48000.0	75.84	
		122	16	3000.0	8	8	24000.0	37.92	

BBS are out of approval

Finally BBS quantities are subject to final approval for as built take-off

T	T 12	T 16	T 18
Unit weight (kg/m)	0.89	1.58	2.00
Total length (mm)	3015000.0	7000100.0	1119800.0
Total weight (kg)	2677.32	26860.16	2239.60
Subtotal: (kg)	31777.08		

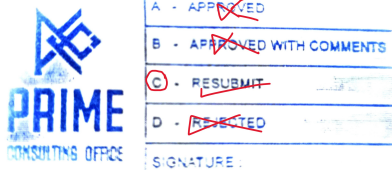

Code / C


GENERAL NOTES				
C. CONCRETE				
C.1. CHARACTERISTIC CONCRETE COMPRESSIVE STRENGTH AT 28 DAYS SHALL BE AS FOLLOWS:				
CONCRETE	28 DAYS CURE STRENGTH (MPa)	MINIMUM CEMENT TYPE	CEMENT SPEC	MAXIMUM W/C
PLAIN CONCRETE (SLABING)	20	250	OPC	0.50
SLAB ON GRADE	25	300	OPC	0.45
FOUNDATION/RETAINING WALLS	25	400	OPC	0.45
SUPER STRUCTURE	25	350	OPC	0.45
C.2. MAXIMUM AGGREGATE SIZE SHALL NOT EXCEED 20 mm.				
C.3. NOMINAL COVER TO ALL REINFORCEMENT (INCLUDING LINKS) SHALL BE AS FOLLOWS:				
STRUCTURAL ELEMENT	mm			
FOUNDATION	50 FOR ALL FACES			
SHEAR WALLS	30 FOR ALL FACES			
RETAINING WALLS	30 AIR SIDE			
COLUMNS	30 FOR ALL FACES			
BEAMS	30 FOR ALL FACES			
SLABS	20 FOR ALL FACES			
C.4. PARAPETS AND LINTELS SHALL BE CAST AFTER STRIKING FORM WORK OF SLABS AND BEAMS. CONTRACTOR TO PROVIDE DOWELS FROM SLABS, BEAMS AND COLUMNS FOR PARAPETS AND LINTELS REINFORCEMENT.				
C.5. ALL FRESHLY PLACED CONCRETE SURFACES SHALL BE PROPERLY CURED, KEPT MOIST AND PROTECTED FROM DIRECT SUNLIGHT.				
C.6. ALL CONSTRUCTION JOINTS OF REINFORCED CONCRETE MEMBERS SHALL BE REINFORCED OR SHALL HAVE SHEAR KEYS. IMMEDIATELY BEFORE NEW CONCRETE IS PLACED ALL CONSTRUCTION JOINTS SHALL BE WETTED AND STANDING WATER REMOVED.				
C.7. ALL CONSTRUCTION JOINTS IN FLOORS SHALL BE LOCATED WITHIN THE MIDDLE THIRD OF SPANS OF SLABS, BEAMS AND GIRDERS. CONSTRUCTION JOINTS IN GIRDERS SHALL BE OFFSET A MINIMUM DISTANCE OF TWO TIMES THE WIDTH OF INTERSECTING BEAMS.				
C.8. WHERE CONCRETE BEAMS ARE CAST IN TWO PHASES, THE SURFACE OF PHASE 1 SHALL BE REINFORCED TO FULL AMPLITUDE OF 6 mm. THE SURFACE SHALL BE KEPT CLEAN, FREE FROM DUST AND LATTICE, AND WET.				
C.9. LOCATION OF CONSTRUCTION JOINT SHALL BE SUBJECT TO THE ENGINEER'S APPROVAL.				
C.10. ALL CONCRETE SHALL BE COMPACTED USING A MECHANICAL VIBRATORS.				
C.11. HEAVY CONSTRUCTION EQUIPMENT AND TRUCKS ARE NOT ALLOWED TO PASS OVER THE GROUND FLOOR SLAB. CONTRACTOR SHALL TAKE ALL THE NECESSARY PRECAUTIONS TO AVOID THIS A CASE.				
C.12. WHEN CASTING A LARGE AREA OR A LARGE VOLUME OF CONCRETE, CONTRACTOR SHALL TAKE ALL THE NECESSARY PRECAUTIONS TO AVOID SHRINKAGE AND THERMAL CRACKS. SUCH AS, AND NOT LIMITED TO, CONSTRUCTION JOINTS, SHRINKAGE STRIPS, PRE-COLORING OF CONCRETE, USE OF ICE IN MIXING WATER, SHADING OF THE CAST CONCRETE AREA AND CURING.				
C.13. MINIMUM PERIOD BEFORE STRIKING FORM WORK SHALL BE IN ACCORDANCE WITH IS 70165.				

01	05-2026	FOR CONSULTANT APPROVAL
00	03-2026	FOR CONSULTANT APPROVAL
REV	DATE	DESCRIPTION
KEY PLAN		
THE BIG BUSINESS DISTRICT New Cairo ,Cairo		

CLIENT:
Consultant:
Consultant:
Contractor:

DESIGN DRAWINGS REFS :	30-04-2026-IFC Package
APPROVAL DATED 30-04-2026	(B01,B02,B03&B04)
	S0001-GENERAL NOTES

Drawing title	
BBS OF R.F.T DETAILS OF ADD BOTTOM & OPENING OF GROUND PART 2 (B1&B2) SHEET (12/15)	
DRAWN BY: MUSERA EHAB	STATUS FOR APPROVAL
CHECKED: Ahmed Ali	DATE: 05 / 2026
APPROVED: HANY MOHSEN	SCALE:1:80
DWG. NO: SAMCO-PCO-SHD-STR-054-012-REV01	

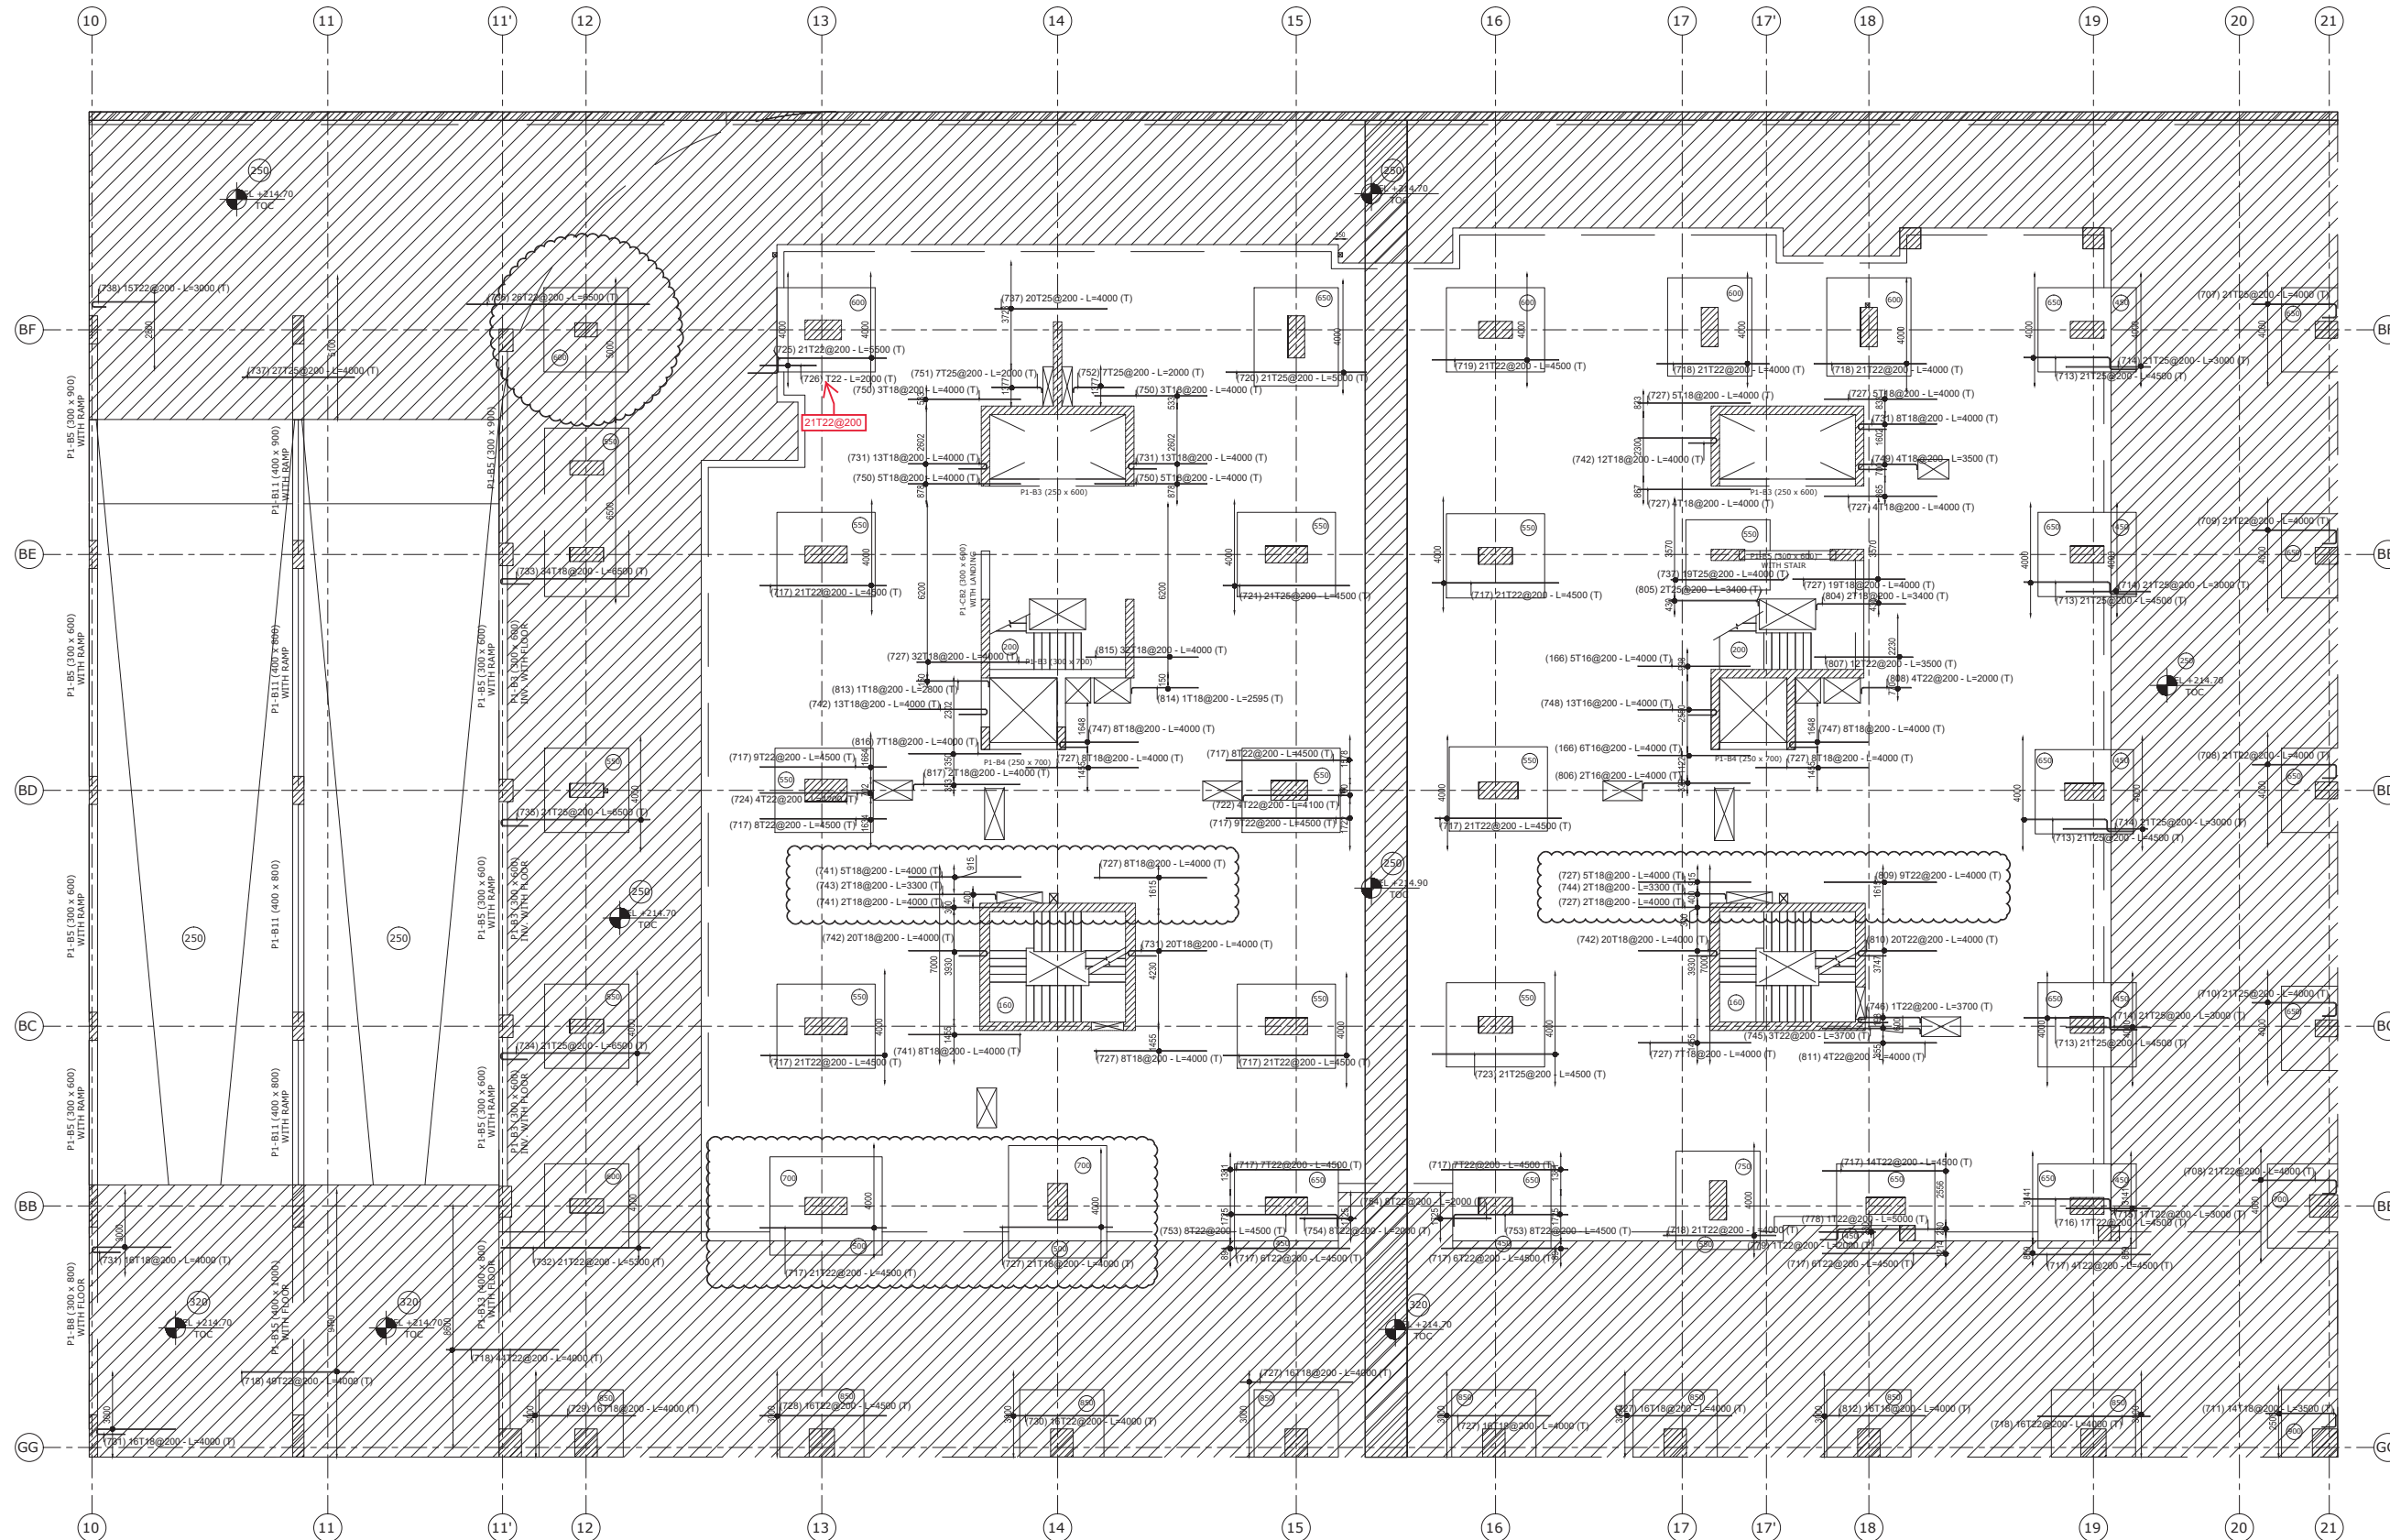

GENERAL NOTES

C. CONCRETE

C.1. CHARACTERISTIC CONCRETE COMPRESSIVE STRENGTH AT 28 DAYS SHALL BE AS FOLLOWS:

CONCRETE	28 DAYS CURE STRENGTH CONCRETE	MINIMUM CEMENT TYPE	MINIMUM CEMENT TYPE	MINIMUM CEMENT TYPE
PLAIN CONCRETE / SLABING	25	300	OPC	0.45
SLAB ON GRADE	25	300	OPC	0.45
FOUNDATION/RETAINING WALLS	25	400	OPC	0.45
RAFTER STRUCTURE	25	300	OPC	0.45

C.2. MAXIMUM AGGREGATE SIZE SHALL NOT EXCEED 20 mm.

C.3. NOMINAL COVER TO ALL REINFORCEMENT (INCLUDING LINKS) SHALL BE AS FOLLOWS UNLESS:

STRUCTURAL ELEMENT	mm
FOUNDATION	50 FOR ALL FACES
BEAM WALLS	30 FOR ALL FACES
RETAINING WALLS	30 FOR ALL FACES
COLUMNS	30 FOR ALL FACES
SLABS	20 FOR ALL FACES

C.4. PARAPETS AND LINTELS SHALL BE CAST AFTER STRIKING FORM WORK OF SLABS AND BEAMS. CONTRACTOR TO PROVIDE DOWELS FROM SLABS, BEAMS AND COLUMNS FOR PARAPETS AND LINTEL REINFORCEMENT.

C.5. ALL FRESHLY POURED CONCRETE SURFACES SHALL BE PROPERLY CURED, KEPT MOIST AND PROTECTED FROM DIRECT SUNLIGHT.

C.6. ALL CONSTRUCTION JOINTS OF REINFORCED CONCRETE MEMBERS SHALL BE REINFORCED OR SHALL HAVE SHEAR KEYS. IMMEDIATELY BEFORE NEW CONCRETE IS PLACED ALL CONSTRUCTION JOINTS SHALL BE WETTED AND STANDING WATER REMOVED.

C.7. ALL CONSTRUCTION JOINTS IN FLOORS SHALL BE LOCATED WITHIN THE MIDDLE THIRD OF SPANS OF SLABS, BEAMS, AND GIRDERS. CONSTRUCTION JOINTS IN GIRDERS SHALL BE OFFSET A MINIMUM DISTANCE OF TWO TIMES THE WIDTH OF INTERSECTING BEAMS.

C.8. WHERE CONCRETE BEAMS ARE CAST IN TWO PHASES, THE SURFACE OF PHASE 1 SHALL BE REINFORCED TO FULL AMPLITUDE OF 8 mm. THE SURFACE SHALL BE KEPT CLEAR FREE FROM DUST AND LINTES, AND SET.

C.9. LOCATION OF CONSTRUCTION JOINT SHALL BE SUBJECT TO THE ENGINEER'S APPROVAL.

C.10. ALL CONCRETE SHALL BE COMPACTED USING A MECHANICAL VIBRATOR.


C.11. HEAVY CONSTRUCTION EQUIPMENT AND TRUCKS ARE NOT ALLOWED TO PASS OVER THE GROUND FLOOR SLAB. CONTRACTOR SHALL TAKE ALL THE NECESSARY PRECAUTIONS TO AVOID SUCH A CASE.

C.12. WHEN CASTING A LARGE AREA OR A LARGE VOLUME OF CONCRETE, CONTRACTOR SHALL TAKE ALL THE NECESSARY PRECAUTIONS TO AVOID OVERHEATING AND THERMAL CRACKS. SUCH AS, AND NOT LIMITED TO, CONSTRUCTION JOINTS, SPRINKLING WATER, COOLING OF CONCRETE, USE OF ICE IN MIXING WATER, SHADING OF THE CAST CONCRETE AREA, AND CURING.

C.13. MINIMUM PERIOD BEFORE STRIKING FORM WORK SHALL BE IN ACCORDANCE WITH ECP 803.

REV	DATE	DESCRIPTION
01	03-2026	FOR CONSULTANT APPROVAL
00	03-2026	FOR CONSULTANT APPROVAL

KEY PLAN

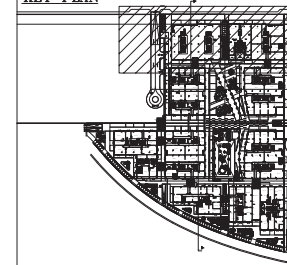

THE BIG BUSINESS DISTRICT
New Cairo, Cairo

CLIENT:



Consultant:



Consultant:



Contractor:



DESIGN DRAWINGS REFS :

APPROVAL DATED 30-04-2026	30-04-2026-IFC Package (801,802,803&804)
	S0001-GENERAL NOTES

Drawing title


R.F.T DETAILS OF ADD-TOP(X-DIRECTION)
OF GROUND PART 2 (B1&B2)
SHEET (13/15)

DRAWN BY : MUSHARA EHAB STATUS FOR APPROVAL

CHECKED: Ahmed Ali DATE: 05 / 2026

APPROVED: HANY MOHSEN SCALE:1:80

DWG. NO: SAMCO-PCO-SHD-STR-054-013-REV02

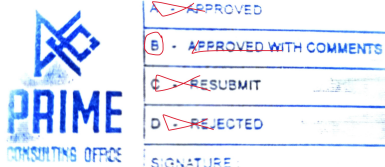

- Any modifications in concrete dimensions approved shop drawings should be reflected in these drawings.

- Only coluded areas are reviewed and approved in this drawing

Code / B



- Any modifications in concrete dimensions approved shop drawings should be reflected in these drawings.
- Only colored areas are reviewed and approved in this drawing

DRAWN BY : MUSERHA EHAB	STATUS FOR APPROVAL
CHECKED: Ahmed Ali	DATE: 05 / 2026
APPROVED: HANY MOHSEN	SCALE: 1:80
DWG. NO: SAMCO-PCO-SHD-STR-054-014-REV02	

Elements		POS.	DIA.	Length (mm)	Number		Total Length (mm)	Mass (kg)	Total mass (kg)
Name	Num				In the element	total			
ADD-TOP	1	166	16	4000.0	11	11	44000.0	69.52	
		231	16	3000.0	21	21	63000.0	99.54	
		704	22	4000.0	32	32	128000.0	381.44	
		707	25	4000.0	21	21	84000.0	323.40	
		708	22	4000.0	42	42	168000.0	500.64	
		709	22	4000.0	21	21	84000.0	250.32	
		710	25	4000.0	21	21	84000.0	323.40	
		711	18	3500.0	14	14	49000.0	98.00	
		713	25	4500.0	84	84	378000.0	1455.36	
		714	25	3000.0	84	84	252000.0	970.20	
		715	22	3000.0	17	17	51000.0	151.98	
		716	22	4500.0	17	17	76500.0	227.97	
		717	22	4500.0	210	210	945000.0	2816.10	
		718	22	4000.0	188	188	752000.0	2240.96	
		719	22	4500.0	21	21	94500.0	281.61	
		720	25	5000.0	21	21	105000.0	404.25	
		721	25	4500.0	42	42	189000.0	727.65	
		722	22	4100.0	4	4	16400.0	48.87	
		723	25	4500.0	21	21	94500.0	353.52	
		724	22	4200.0	4	4	16800.0	50.05	
		725	22	5500.0	21	21	115500.0	344.13	
		726	22	2000.0	1	1	2000.0	5.96	
		727	18	4000.0	184	184	736000.0	1472.00	
		728	22	4500.0	16	16	72000.0	214.56	
		729	18	4000.0	16	16	64000.0	128.00	
		730	22	4000.0	16	16	64000.0	190.72	
		731	18	4000.0	86	86	344000.0	888.00	
		732	22	5300.0	21	21	111300.0	331.67	
		733	18	6500.0	34	34	221000.0	442.00	
		734	25	6500.0	21	21	136500.0	525.52	
		735	25	6500.0	21	21	136500.0	525.52	
		736	22	6500.0	26	26	169000.0	503.62	
		737	25	4000.0	129	129	516000.0	1986.60	
		738	22	3000.0	15	15	45000.0	134.10	
		741	18	4000.0	15	15	60000.0	120.00	
		742	18	4000.0	65	65	260000.0	520.00	
		743	18	3300.0	2	2	6600.0	13.20	
		744	18	3300.0	2	2	6600.0	13.20	
		745	22	3700.0	3	3	11100.0	33.08	
		746	22	3700.0	1	1	3700.0	11.03	
		747	18	4000.0	16	16	64000.0	128.00	
		748	16	4000.0	13	13	52000.0	82.16	
		749	18	3500.0	4	4	14000.0	28.00	
		750	18	4000.0	16	16	64000.0	128.00	
		751	25	2000.0	7	7	14000.0	53.90	
		752	25	2000.0	7	7	14000.0	53.90	
		753	22	4500.0	16	16	72000.0	214.56	
		754	22	2000.0	16	16	32000.0	95.36	
		778	22	5000.0	1	1	5000.0	14.90	
		779	22	2000.0	1	1	2000.0	5.96	
		780	22	4500.0	21	21	94500.0	281.61	
		781	25	4000.0	45	45	180000.0	593.00	
		782	16	4000.0	32	32	128000.0	202.24	
		783	16	3700.0	10	10	37000.0	58.46	
		784	18	2500.0	10	10	25000.0	50.00	
		785	18	2500.0	18	18	45000.0	90.00	
		786	18	2500.0	3	3	7500.0	15.00	
		787	18	2500.0	1	1	2500.0	5.00	
		788	16	4000.0	24	24	96000.0	151.68	
		789	16	4000.0	15	15	60000.0	94.80	
		790	25	2500.0	22	22	55000.0	211.75	
		791	22	4000.0	40	40	160000.0	476.80	
		792	25	4000.0	61	61	244000.0	639.40	
		793	22	4000.0	24	24	96000.0	286.08	
		794	22	1800.0	4	4	7200.0	21.46	
		795	25	1800.0	4	4	7200.0	27.72	
		796	16	2500.0	20	20	50000.0	79.00	
		797	16	2480.0	14	14	34720.0	54.86	
		798	16	2500.0	16	16	40000.0	63.20	
		799	16	4760.0	8	8	38080.0	60.17	
		800	18	2500.0	9	9	22500.0	45.00	
		801	16	4760.0	8	8	38080.0	60.17	
		802	18	2500.0	19	19	47500.0	95.00	
		803	18	2500.0	4	4	10000.0	20.00	
		804	18	3400.0	2	2	6800.0	13.60	
		805	25	3400.0	2	2	6800.0	26.18	
		806	16	4000.0	2	2	8000.0	12.64	
		807	22	3500.0	12	12	42000.0	125.16	
		808	22	2000.0	4	4	8000.0	23.84	
		809	22	4000.0	9	9	36000.0	107.28	
		810	22	4000.0	20	20	80000.0	238.40	
		811	22	4000.0	4	4	16000.0	47.68	
		812	18	4000.0	16	16	64000.0	128.00	
		813	18	2800.0	1	1	2800.0	5.60	
		814	18	2595.0	1	1	2595.0	5.19	
		815	18	4000.0	32	32	128000.0	256.00	
		816	18	4000.0	7	7	28000.0	56.00	
		817	18	4000.0	2	2	8000.0	16.00	
		818	18	4000.0	21	21	84000.0	168.00	
		819	22	4000.0	21	21	84000.0	250.32	
		820	25	4000.0	21	21	84000.0	323.40	
		821	25	4000.0	36	36	144000.0	354.40	
		822	25	6500.0	21	21	136500.0	525.52	
		823	25	4000.0	21	21	84000.0	323.40	
		824	25	4000.0	21	21	84000.0	323.40	
		825	22	4000.0	21	21	84000.0	250.32	
		826	18	4000.0	21	21	84000.0	168.00	
		827	25	4000.0	21	21	84000.0	323.40	
		828	18	4000.0	21	21	84000.0	168.00	
		829	18	4000.0	21	21	84000.0	168.00	
		830	18	4000.0	21	21	84000.0	168.00	
		831	18	4000.0	21	21	84000.0	168.00	
		832	18	4000.0	21	21	84000.0	168.00	
		833	18	4000.0	14	14	56000.0	112.00	
		834	22	4800.0	21	21	100800.0	300.36	
		835	22	2700.0	21	21	56700.0	168.97	
		836	25	5300.0	21	21	111300.0	428.51	
		837	25	3000.0	21	21	63000.0	242.55	
		838	22	4800.0	20	20	96000.0	286.08	
		839	22	2700.0	20	20	54000.0	160.92	
		840	22	3000.0	1	1	3000.0	8.94	
		841	22	4000.0	1	1	4000.0	11.92	
		842	22	4800.0	20	20	96000.0	286.08	
		843	22	2700.0	20	20	54000.0	160.92	
		844	22	3000.0	1	1	3000.0	8.94	
		845	22	4000.0	1	1	4000.0	11.92	

823	25	4000.0	21	21	84000.0	323.40
824	25	4000.0	21	21	84000.0	323.40
825	22	4000.0	21	21	84000.0	250.32
826	18	4000.0	21	21	84000.0	168.00
827	25	4000.0	21	21	84000.0	323.40
828	18	4000.0	21	21	84000.0	168.00
829	18	4000.0	21	21	84000.0	168.00
830	18	4000.0	21	21	84000.0	168.00
831	18	4000.0	21	21	84000.0	168.00
832	18	4000.0	21	21	84000.0	168.00
833	18	4000.0	14	14	56000.0	112.00
834	22	4800.0	21	21	100800.0	300.36
835	22	2700.0	21	21	56700.0	168.97
836	25	5300.0	21	21	111300.0	428.51
837	25	3000.0	21	21	63000.0	242.55
838	22	4800.0	20	20	96000.0	286.08
839	22	2700.0	20	20	54000.0	160.92
840	22	3000.0	1	1	3000.0	8.94
841	22	4000.0	1	1	4000.0	11.92
842	22	4800.0	20	20	96000.0	286.08
843	22	2700.0	20	20	54000.0	160.92
844	22	3000.0	1	1	3000.0	8.94
845	22	4000.0	1	1	4000.0	11.92
846	22	5400.0	21	21	113400.0	337.93
847	22	2700.0	21	21	56700.0	168.97
848	22	4200.0	14	14	58800.0	175.22
849	22	2700.0	14	14	37800.0	112.64
850	25	5000.0	16	16	80000.0	308.00
851	25	3000.0	16	16	48000.0	184.80
852	25	4000.0	7	7	28000.0	107.80
853	22	4800.0	7	7	33600.0	100.13
854	22	2700.0	7	7	18900.0	56.32
855	25	4000.0	16	16	64000.0	246.40
856	25	4000.0	16	16	64000.0	246.40
857	25	4000.0	16	16	64000.0	246.40
858	25	4000.0	16	16	64000.0	246.40
859	25	4000.0	16	16	64000.0	246.40
860	25	4000.0	24	24	96000.0	369.60
861	25	4000.0	21	21	84000.0	323.40
862	25	4000.0	24	24	96000.0	369.60
863	25	4000.0	21	21	84000.0	323.40
865	25	3000.0	2	2	6000.0	23.10
866	25	2500.0	44	44	110000.0	423.50
867	25	2500.0	8	8	20000.0	77.00
868	16	4000.0	23	23	92000.0	445.36
869	16	4000.0	9	9	36000.0	56.88
870	16	3600.0	3	3	10800.0	17.06
871	16	3600.0	1	1	3600.0	5.69
872	22	3000.0	2	2	6000.0	17.88
873	22	3800.0	1	1	3800.0	11.32
874	16	3000.0	21	21	63000.0	99.54
882	18	2500.0	25	25	62500.0	125.00
883	18	2500.0	10	10	25000.0	50.00