

The Big
SHOP DRAWING (SDW)

Project	The Big Business District	S.D/Submittal No.	Rev.
Owner	ROYA Developments	BD-CW-SAMCO-PCO-SDW-STR-055	02
Project Manager	ACE-PM	Date: 16-06-2026	
Supervision Consultant	PRIME CONSULTING OFFICE	Submitted For	
Contractor	SAMCO National Construction	Approval	
		Information	

SD Subject	RFT DETAILS OF GROUND FLOOR B3&B4	Action (2)
Location	PART(01)	Approved
Attachment	(1) A3 Sheet	Approved as Noted
		Revise and Resubmit
		Rejected

WE TRANSMIT HERewith / UNDER SEPARATE COVER, THE DRAWINGS,CALCULATION,ETC. LISTED BELOW.

Ser.	Drawing No.	Rev.	DESCRIPTION	SUBMITTAL CODE*	ACTION CODE **
1	SAMCO-PCO-SHD-STR-055-011	2	R.F.T DETAILS OF(ADD-BOTTOM) GROUND FLOOR FOR (B3&B4)-PART (1) AT LEVEL(+214.90)		Code / B

CONTRACTOR :  DATE : _____


RECEIVED BY : _____ DATE : _____

COPIES: _____

Consultant to enter ACTION CODE and REMARKS

Supervision Consultant Remarks :

- Follow all comments stated on the attached drawing.
- IFC design drawings should be followed.
- Any modifications on concrete dimension drawings should be reflected on these drawings.
- Only clouded area are reviewed and approved in the attached drawing.
- Finally BBS quantities are subject to final approval for as built take-off

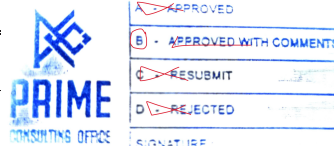

Supervision Consultant: M.Mamdouh DATE : 21/06/2026

Corrections or comments made relative to submittals during this review does not relieve the contractor from compliance with the requirements of the drawings and specifications. This check is only for review of general conformance with the design concept of the project and general compliance with the information given in the contract documents. The contractor is responsible for confirming and correlating all quantities and dimensions, selecting fabrication process and techniques of construction; coordinating his work with that of other trades, and performing his work in a safe and satisfactory manner.


Project Manager Remarks (If Required):

Project Manager: _____ DATE : _____


Received by Contractor: _____ DATE : _____

COPIES:		* SUBMITTAL CODE:		** ACTION CODE:	
+ TYPE:	SD Shop Drawings	1:	Submitted for Approval	A:	Approved
	SM Sample	2:	Submitted for Information	B:	Approved as Noted
	GT Guarantee			C:	Revise and Resubmit
	MD Manufacturer's Data			D:	Rejected
	CT Certificates				
	OT Others				

Structure	Architecture	Surveying	Electrical	Mechanical	Landscape	Infra & Roads	Other
-----------	--------------	-----------	------------	------------	-----------	---------------	-------

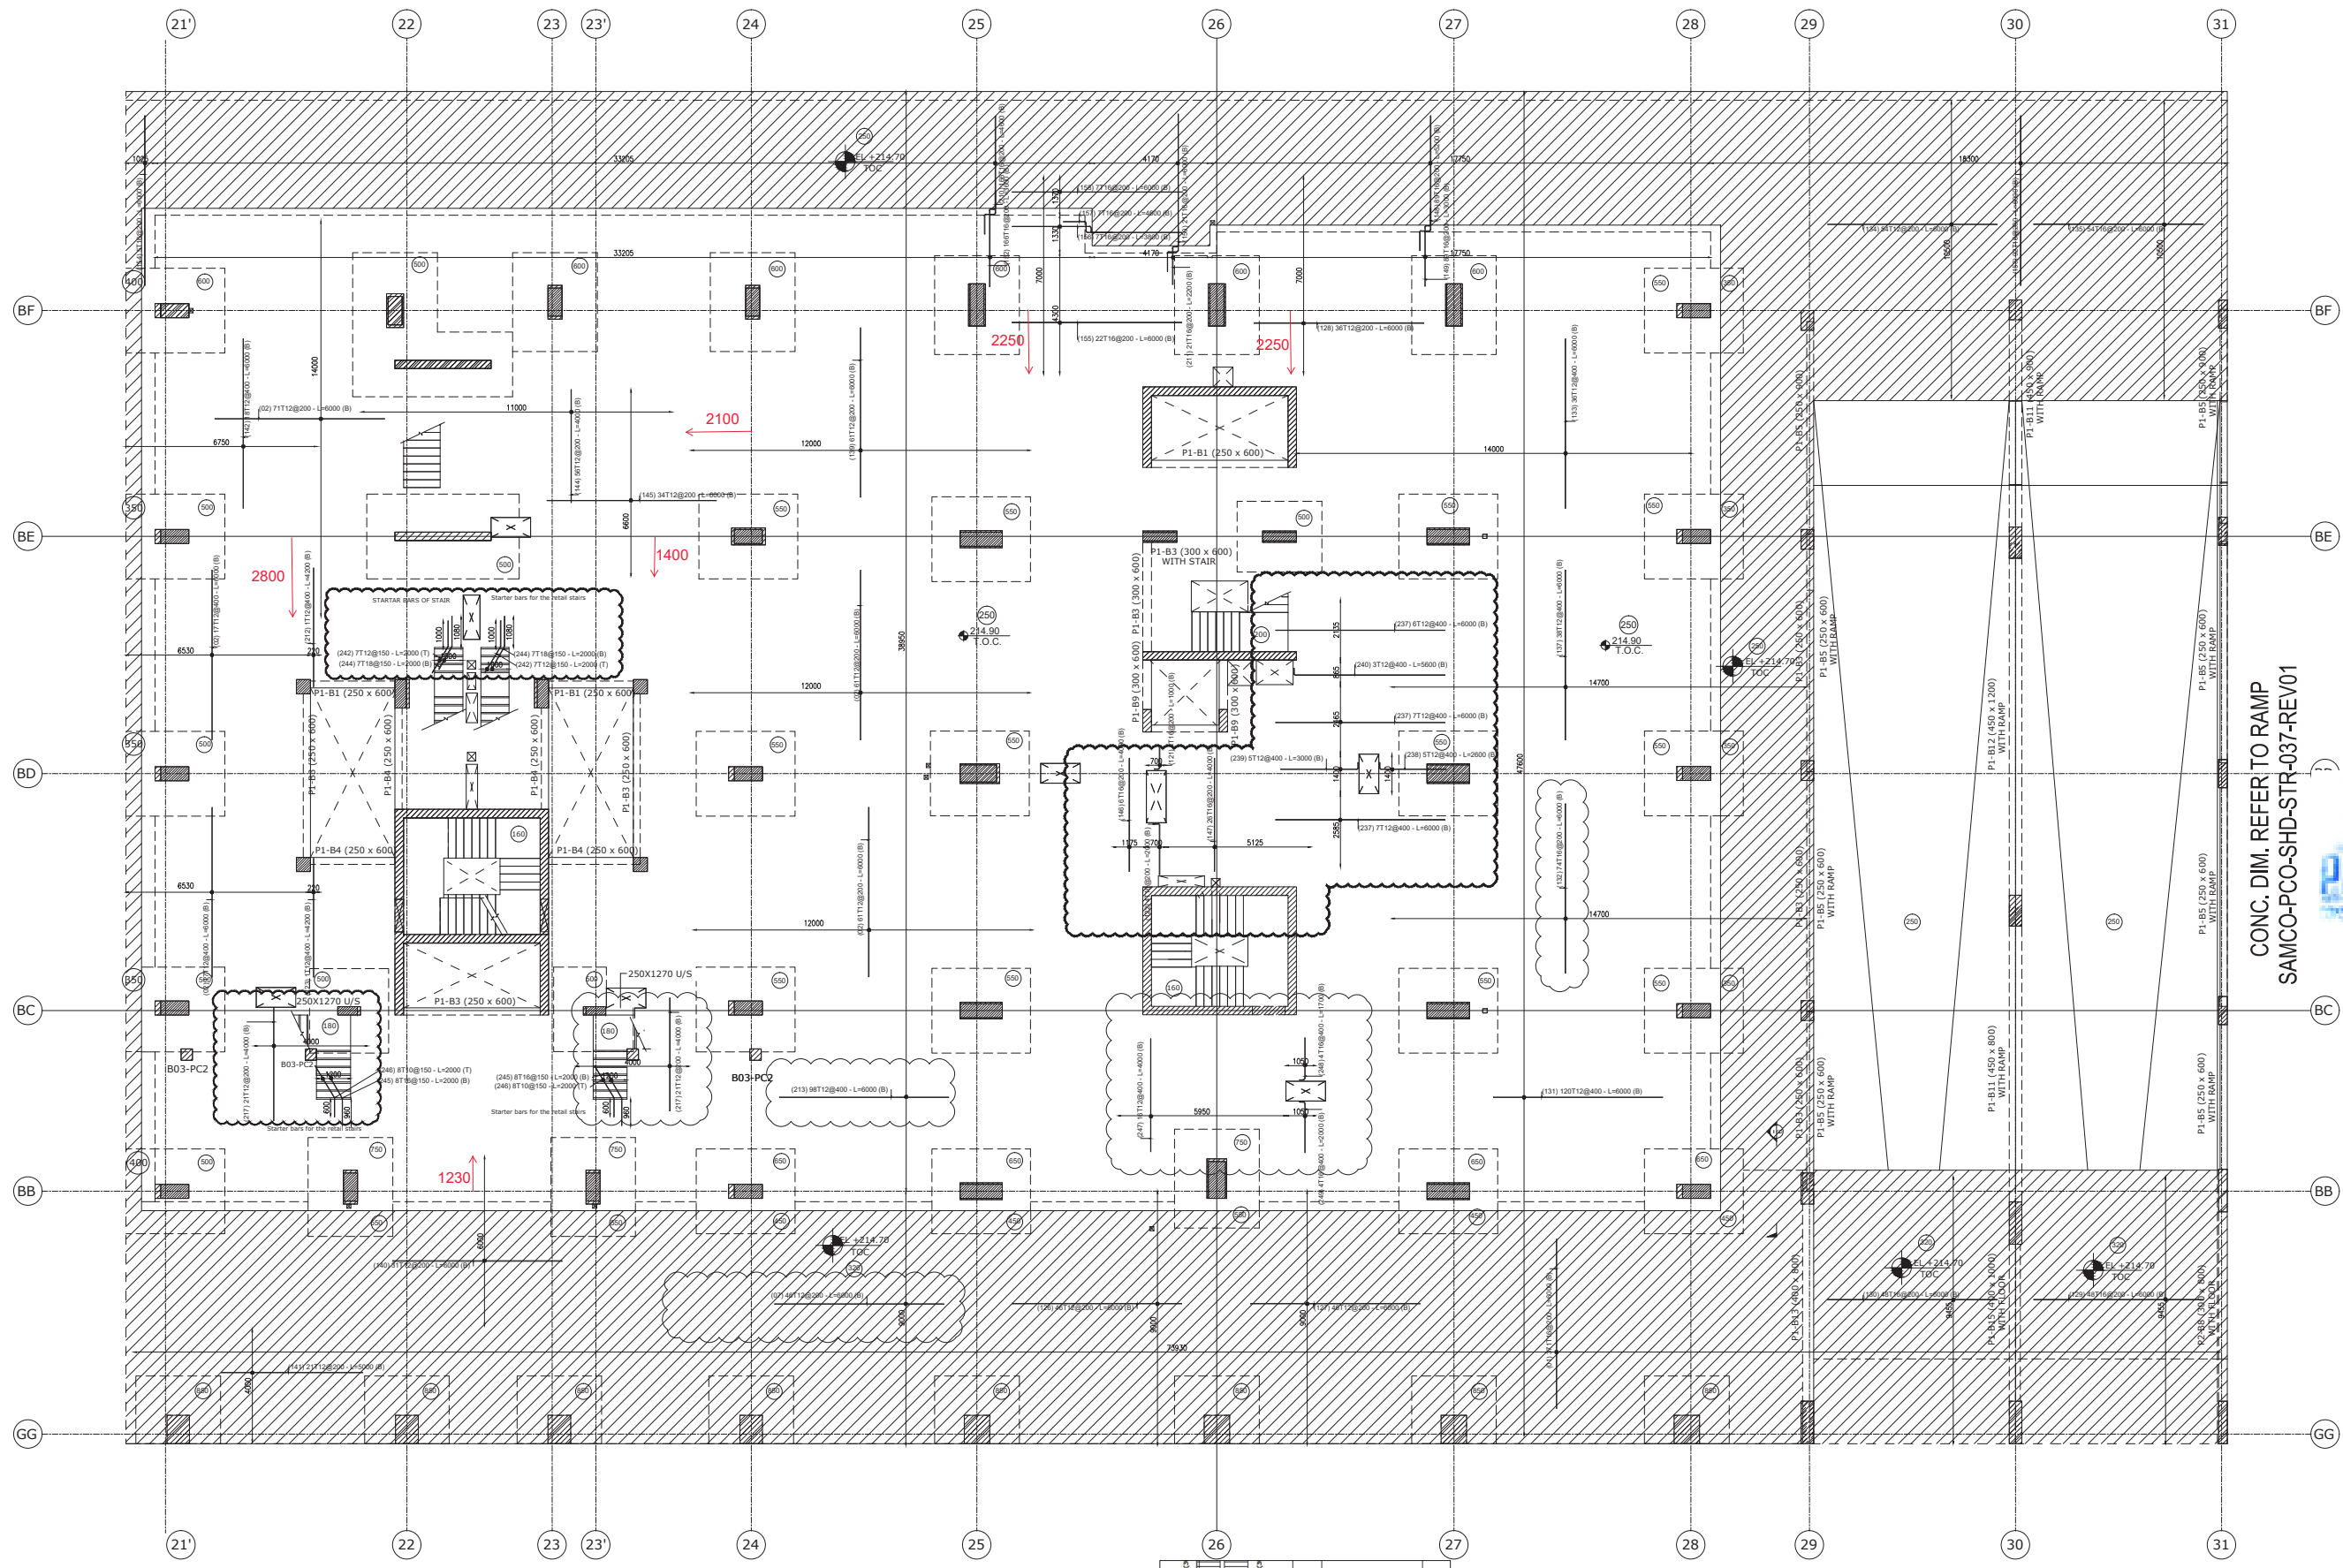

As per the approved comment, only the retail stair shaft openings will be constructed, and the stair itself has not been executed yet. Starter rebars for the retail stairs will also be provided and left ready for future construction, if required.

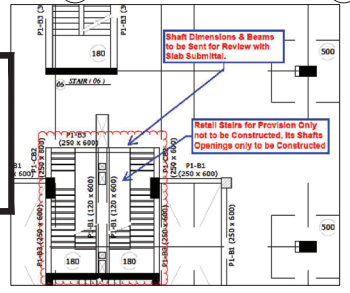

- Only clouded area are reviewed and approved in this drawing.
- Additional bars should be connected to axis with dimension lines

Code / B

GENERAL NOTES

C-1: CHARACTERISTIC CONCRETE COMPRESSIVE STRENGTH AT 28 DAYS SHALL BE AS FOLLOWS:

CONCRETE	TEST STRENGTH	DESIGN STRENGTH	CEMENT TYPE	WATER/CEMENT RATIO
PLAIN CONCRETE / SLAB ON GRADE	25	20	OPC	0.45
FOUNDATION / RETAINING WALLS	30	25	OPC	0.45
SLAB ON GRADE	25	20	OPC	0.45

C-2: MAXIMUM AGGREGATE SIZE SHALL NOT EXCEED 20 mm.

C-3: NORMAL COVER TO ALL REINFORCEMENT (INCLUDING LAPPED) SHALL BE AS FOLLOWS (mm):

STRUCTURAL ELEMENT	COVER
FOUNDATION	50 FOR ALL FACES
BEAR WALLS	25 FOR ALL FACES
RETAINING WALLS	50 FOR ALL FACES
COLUMNS	25 FOR ALL FACES
BEAMS	25 FOR ALL FACES
SLABS	25 FOR ALL FACES

C-4: FORMWORK AND LATHES SHALL BE CAST AFTER STRIKING FORMWORK OF SLAB AND BEAMS. CONSTRUCTION TO PROCEED IMMEDIATELY AFTER SLAB, BEAM, AND FORMWORK REMOVAL.

C-5: ALL PRECAST CONCRETE SURFACES SHALL BE PROPERLY CURED, KEPT MOIST AND PROTECTED FROM DIRECT SUNLIGHT.

C-6: ALL CONSTRUCTION JOINTS IN FLOORS SHALL BE LOCATED WITHIN THE MIDDLE THIRD OF SPAN OF SLAB. BEAMS AND GIRDERS CONSTRUCTION JOINTS IN GIRDERS SHALL BE LOCATED WITHIN THE MIDDLE THIRD OF SPAN OF GIRDER.

C-7: WHEN CASTING A LARGE AREA OR A LARGE VOLUME OF CONCRETE, CONSTRUCTION SHALL TAKE ALL THE NECESSARY PRECAUTIONS TO AVOID OVERHEATING AND THERMAL CRACKS SUCH AS AND NOT LIMITED TO: CONSTRUCTION JOINTS, SHORING, STRUTS, PRE-COOLING OF CONCRETE, USE OF ICE IN MIXING WATER, SHADING OF THE CAST CONCRETE, ETC.

C-8: MINIMUM PERIOD BEFORE STRIKING FORM SHALL BE IN ACCORDANCE WITH C-1.

D. REINFORCEMENT:

D-1: REINFORCEMENT BARS SHALL BE AS FOLLOWS:

- MAIN REINFORCEMENT BARS (R1) SHALL BE OF GRADE 60 (R60) (fy = 600 MPa) CONFORMING TO BS 8882:2015.

REV02	06-2026	FOR CONSULTANT APPROVAL
REV01	06-2026	FOR CONSULTANT APPROVAL
REV00	03-2026	FOR CONSULTANT APPROVAL
REV	DATE	DESCRIPTION
KEY PLAN		



THE BIG BUSINESS DISTRICT
New Cairo, Cairo

CLIENT: **ROYA**

Consultant: **ACE-PM**
MOHARRAM BAKHOUM

Consultant: **PRIME**
CONSULTING OFFICE

Contractor: **SAMCO**
SAMCO National Construction Co.
شركة سامكو الوطنية للبناء

DESIGN DRAWINGS REFS :	S1000 - S1001 - S1002
APPROVAL DATED 30-04-2026	S1220 - S1221

Drawing title
R.F.T DETAILS OF(ADD-BOTTOM) GROUND FLOOR FOR (B3&B4)-PART (1) AT LEVEL(+214.90) SHEET (11/15)

DRAWN BY : FATMA TAHER STATUS FOR APPROVAL
CHECKED: Ahmed Ali DATE: 06/2026
APPROVED: HANY MOHSEN SCALE:1:80
DWG. NO: SAMCO-PCO-SHD-STR-055-011-REV02