

## The Big

## SHOP DRAWING (SDW)

|                        |                                         |                                        |      |
|------------------------|-----------------------------------------|----------------------------------------|------|
| Project                | The Big Business District               | S.D/Submittal No.                      | Rev. |
| Owner                  | ROYA Developments                       | BD-CW-SAMCO-PCO-SDW-STR-044            | 03   |
| Project Manager        | ACE-PM                                  | Date: <del>11-05-2026</del> 12-05-2026 |      |
| Supervision Consultant | PRIME CONSULTING OFFICE                 | Submitted For                          |      |
| Contractor             | SAMCO National Construction             | Approval                               |      |
|                        |                                         | Information                            |      |
| SD Subject             | R.F.T OF SLAB B1&B2 PART(02) (BASEMENT) |                                        |      |
| Location               | PART ( 02 )                             |                                        |      |
| Attachment             | (1) A3 Sheet                            |                                        |      |

WE TRANSMIT HERewith / UNDER SEPARATE COVER, THE DRAWINGS,CALCULATION,ETC. LISTED BELOW.

| Ser. | Drawing No.               | Rev. | DESCRIPTION                                        | SUBMITTAL CODE* | ACTION CODE ** |
|------|---------------------------|------|----------------------------------------------------|-----------------|----------------|
| 1    | SAMCO-PCO-SHD-STR-044-010 | 3    | R.F.T DETAILS OF TOP ADD OF BASEMENT PARTI (B1&B2) |                 |                |

CONTRACTOR :



DATE : \_\_\_\_\_

RECEIVED BY :

DATE : \_\_\_\_\_

COPIES:


Consultant to enter ACTION CODE and REMARKS

Supervision Consultant Remarks :

Approved for reinforcement details for clouded openings

Supervision Consultant:

Khaled Elwan

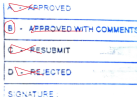

DATE : 18/05/2026

Corrections or comments made relative to submittals during this review does not relieve the contractor from compliance with the requirements of the drawings and specifications. This check is only for review of general conformance with the design concept of the project and general compliance with the information given in the contract documents. The contractor is responsible for confirming and correlating all quantities and dimensions, selecting fabrication process and techniques of construction; coordinating his work with that of other trades, and performing his work in a safe and satisfactory manner.

Project Manager Remarks (If Required):

Project Manager:

DATE : \_\_\_\_\_

Received by Contractor:

DATE : \_\_\_\_\_

COPIES:


+ TYPE: SD Shop Drawings  
SM Sample  
GT Guarantee  
MD Manufacturer's Data  
CT Certificates  
OT Others

\* SUBMITTAL CODE:  
1: Submitted for Approval  
2: Submitted for Information

\*\* ACTION CODE:  
A: Approved  
B: Approved as Noted  
C: Revise and Resubmit  
D: Rejected

| Structure | Architecture | Surveying | Electrical | Mechanical | Landscape | Infra & Roads | Other |
|-----------|--------------|-----------|------------|------------|-----------|---------------|-------|
|-----------|--------------|-----------|------------|------------|-----------|---------------|-------|



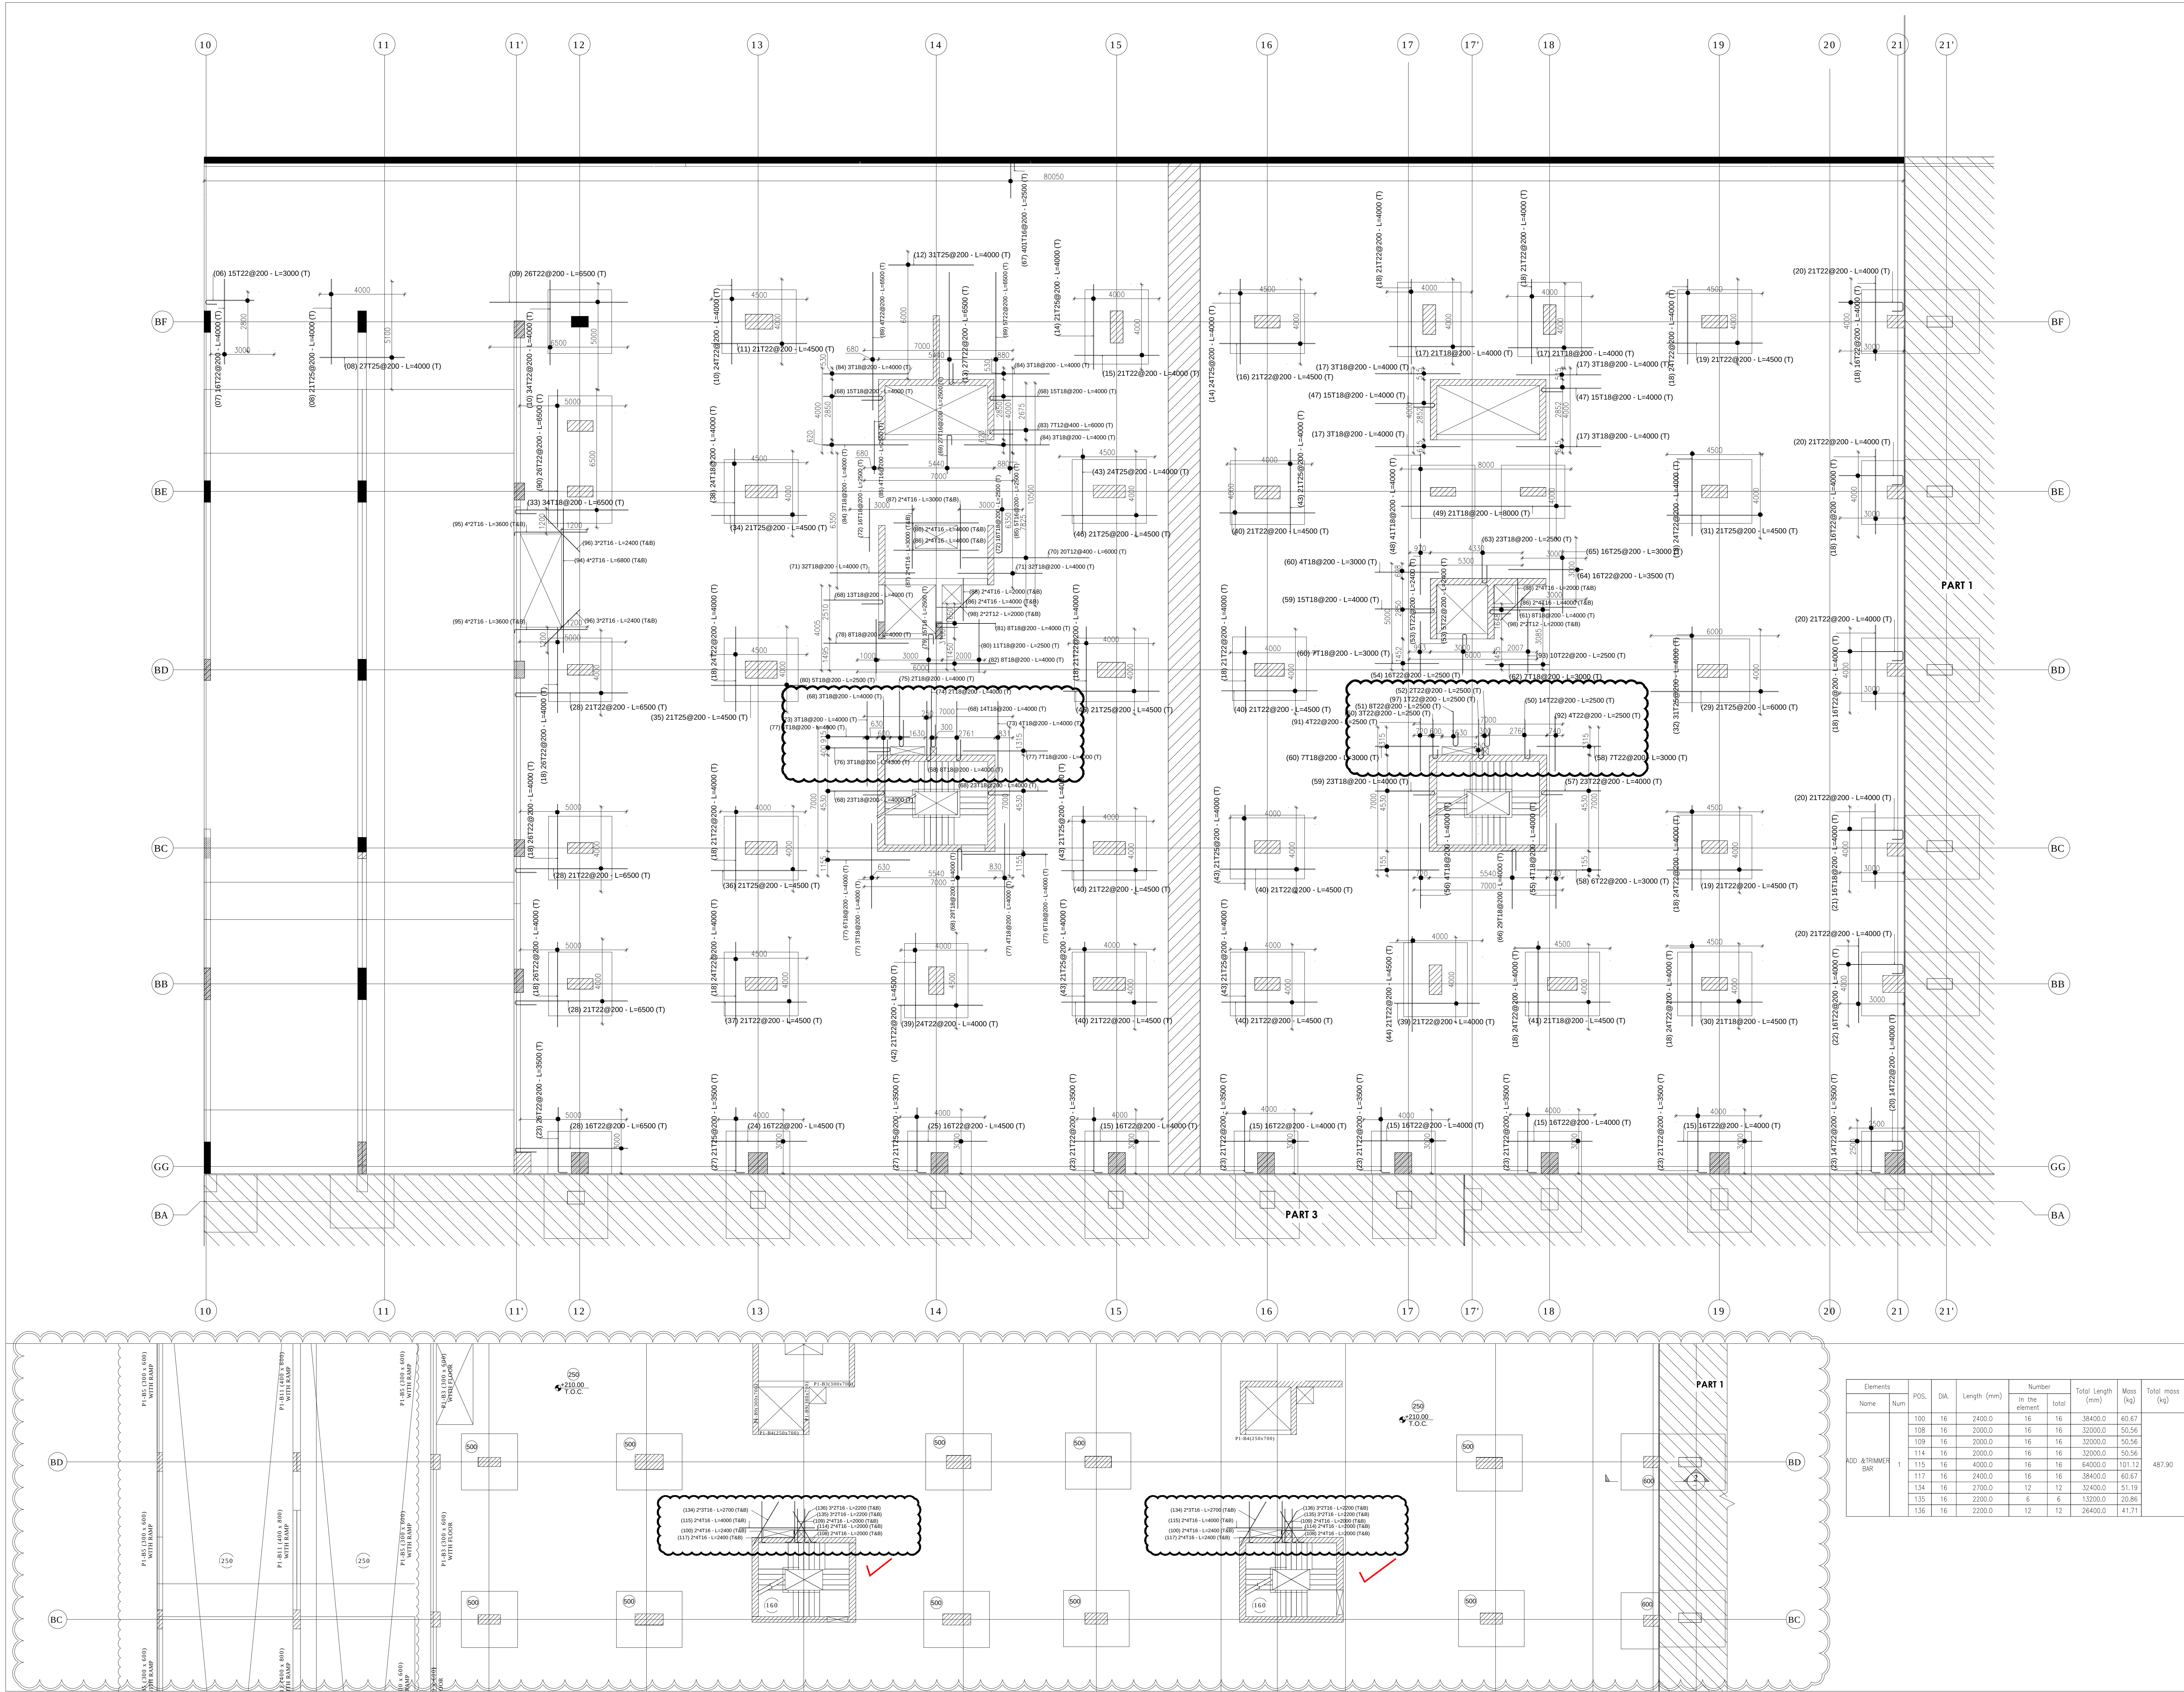

| GENERAL NOTES   |                                 |                       |             |        |             |
|---|---------------------------------|-----------------------|-------------|--------|-------------|
| C. CONCRETE   |                                 |                       |             |        |             |
| C.1. CHARACTERISTIC CONCRETE COMPRESSIVE STRENGTH AT 28 DAYS SHALL BE AS FOLLOWS:   |                                 |                       |             |        |             |
| CONCRETE   | TEST SPECIFICATION (EN 12390-1) | DESIGN STRENGTH (MPa) | CEMENT TYPE | CEMENT | MAXIMUM W/C |
| PLAIN CONCRETE (FLOORING)   | 25                              | 300                   | OPC         | OPC    | 0.45        |
| SLAB ON GRADE   | 25                              | 300                   | OPC         | OPC    | 0.45        |
| FOUNDATION/RETAINING WALLS   | 30                              | 400                   | OPC         | OPC    | 0.45        |
| SUPER STRUCTURE   | 30                              | 300                   | OPC         | OPC    | 0.45        |
| C.2. MAXIMUM AGGREGATE SIZE SHALL NOT EXCEED 20 MM.   |                                 |                       |             |        |             |
| C.3. MINIMUM COVER TO ALL REINFORCEMENT (INCLUDING LINKS) SHALL BE AS FOLLOWS (MM):   |                                 |                       |             |        |             |
| STRUCTURAL ELEMENT   | mm                              |                       |             |        |             |
| FOUNDATION   | 50 FOR ALL FACES                |                       |             |        |             |
| BEAM WALLS   | 30 FOR ALL FACES                |                       |             |        |             |
| RETAINING WALLS   | 30 FOR ALL FACES                |                       |             |        |             |
| COLUMNS   | 30 FOR ALL FACES                |                       |             |        |             |
| BEAMS   | 30 FOR ALL FACES                |                       |             |        |             |
| SLABS   | 25 FOR ALL FACES                |                       |             |        |             |
| C.4. REINFORCEMENT LAYERS SHALL BE CAST AFTER STRIPPING FORMWORK OF SLABS AND BEAMS. CONTRACTOR TO PROVIDE SCHEDULES FROM SLABS BEAMS AND COLUMNS FOR REINFORCEMENT AND LAYERS REINFORCEMENT.   |                                 |                       |             |        |             |
| C.5. ALL EXPOSED FOUNDED CONCRETE SURFACES SHALL BE PROPERLY CURED, KEPT MOIST AND PROTECTED FROM DIRECT SUNLIGHT.   |                                 |                       |             |        |             |
| C.6. ALL CONSTRUCTION JOINTS OF REINFORCED CONCRETE MEMBERS SHALL BE LOCATED WITHIN THE MIDDLE THIRD OF THE MEMBER. REINFORCEMENT JOINTS SHALL BE LOCATED WITHIN THE MIDDLE THIRD OF THE MEMBER. |                                 |                       |             |        |             |
| C.7. ALL CONSTRUCTION JOINTS IN FLOORS SHALL BE LOCATED WITHIN THE MIDDLE THIRD OF THE MEMBER. REINFORCEMENT JOINTS SHALL BE LOCATED WITHIN THE MIDDLE THIRD OF THE MEMBER.                      |                                 |                       |             |        |             |
| C.8. WHERE CONCRETE BEAMS ARE CAST IN TWO PHASES, THE SURFACE OF PHASE 1 SHALL BE REINFORCED TO FULL DEPTH OF 100 MM. THE SURFACE SHALL BE CLEAN, FREE FROM DUST AND LATTICE AND WET.   |                                 |                       |             |        |             |
| C.9. LOCATION OF CONSTRUCTION JOINT SHALL BE SUBJECT TO THE ENGINEER'S APPROVAL.   |                                 |                       |             |        |             |
| C.10. ALL CONCRETE SHALL BE COMPACTED USING A MECHANICAL VIBRATOR.   |                                 |                       |             |        |             |
| C.11. HEAVY CONSTRUCTION EQUIPMENT AND TRUCKS ARE NOT ALLOWED TO PASS OVER THE FLOORS SLAB UNTIL THE CONTRACTOR HAS FULFILLED ALL THE NECESSARY PRECAUTIONS TO AVOID SUCH A CASE.   |                                 |                       |             |        |             |
| C.12. WHEN CASTING A LARGE AREA OF A LARGE VOLUME OF CONCRETE, CONTRACTOR SHALL TAKE ALL THE NECESSARY PRECAUTIONS TO AVOID SHRINKAGE AND CRACKING. CHECKS SUCH AS NOT LIMITED TO: CONSTRUCTION JOINTS, SHRINKAGE JOINTS, PRE-COOLING OF CONCRETE, USE OF ICE IN MIXING WATER, SHADING OF THE CAST CONCRETE AREA AND CURING.                               |                                 |                       |             |        |             |
| C.13. BOTTOM FORMS OF BEAMS AND SLABS OF SPANS GREATER THAN OR EQUAL TO 8.0 M SHALL HAVE A CAMBER OF 1/200 OF THE SPAN FOR COUNTERING OF SPAN GREATER THAN 1.0 M. THE CAMBER SHALL BE 1/200 OF THE SPAN.   |                                 |                       |             |        |             |
| C.14. COVER FOR ALL EXPOSED CONCRETE ELEMENTS ABOVE GROUND LEVEL SHALL HAVE 25mm (1") MINIMUM.   |                                 |                       |             |        |             |

Rev0305-2026FOR CONSULTANT APPROVAL

Rev0204-2026FOR CONSULTANT APPROVAL

Rev0102-2026FOR CONSULTANT APPROVAL

Rev0002-2026FOR CONSULTANT APPROVAL

| DATE    | DESCRIPTION             |
|---------|-------------------------|
| 05-2026 | FOR CONSULTANT APPROVAL |
| 04-2026 | FOR CONSULTANT APPROVAL |
| 02-2026 | FOR CONSULTANT APPROVAL |
| 02-2026 | FOR CONSULTANT APPROVAL |

KEY PLAN

THE BIG BUSINESS DISTRICT  
New Cairo ,Cairo

CLIENT:

Consultant:

Consultant:

Contractor:

|                            |  |                        |
|----------------------------|--|------------------------|
| DESIGN DRAWINGS: REFS :    |  | 30.04.2026-IFC Package |
| APPROVAL DATED: 30-04-2026 |  | (B01,B02,B03&B04)      |
|                            |  | SC001-GENERAL NOTES    |

Drawing title  
R.F.T. DETAILS OF TOP ADD  
OF BASEMENT PART I (B1&B2)  
SHEET (10/11)

|                                          |                     |
|------------------------------------------|---------------------|
| DRAWN BY : FATMA TAHER                   | STATUS FOR APPROVAL |
| CHECKED: Ahmed Ali                       | DATE: 05/2026       |
| APPROVED: HANY MOHSEN                    | SCALE: 1:80         |
| DWG. NO: SAMCO-PCO-SHD-STR-044-010-REV03 |                     |